


T.6N. R.34E.W.M.

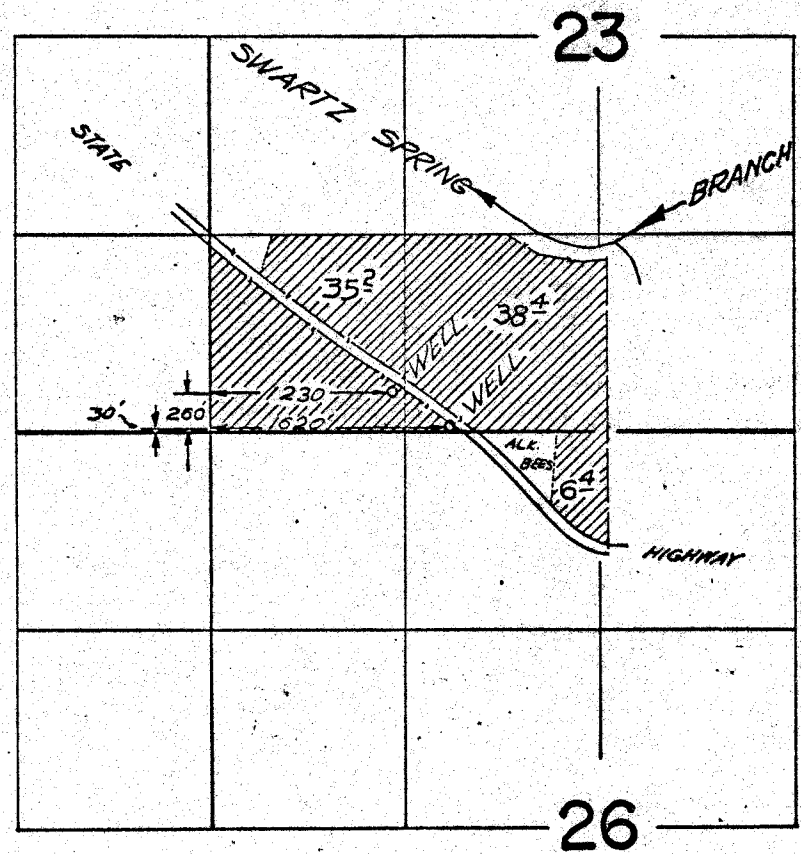

FINAL PROOF SURVEY UNDER

Application No. G-2290 Permit No. G-2583
G-2983 Permit No. G-2777
IN NAME OF

KEY BROS. INC.

Surveyed Oct. 29, 1966, by V. GARNER