


T.39S.R.1&2E.W.M.

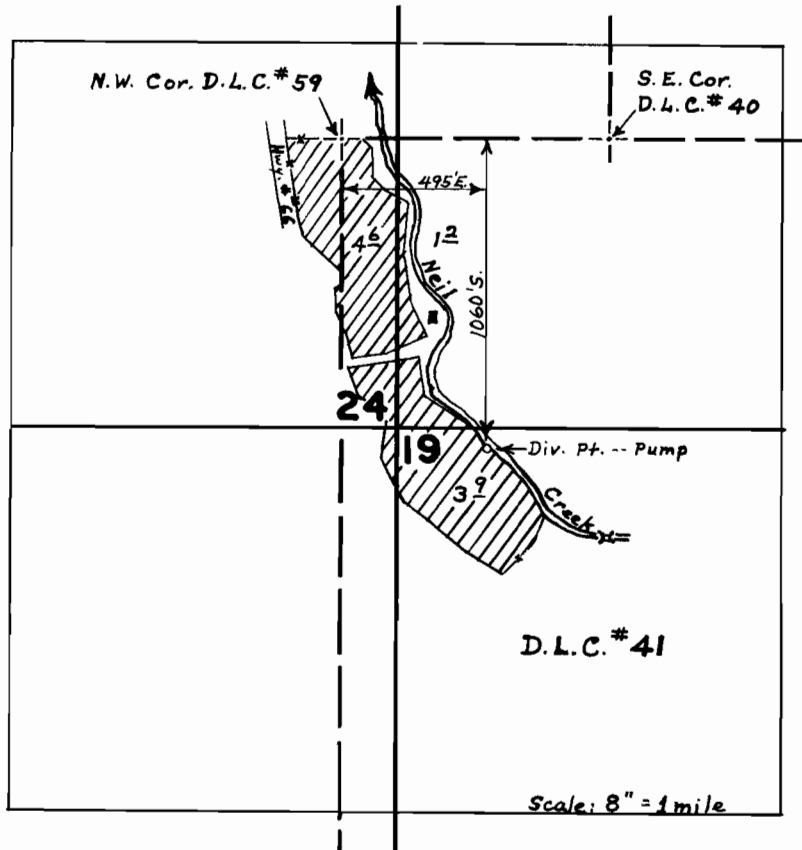

FINAL PROOF SURVEY UNDER

Transfer No. 0-46

Application No. Permit No.

IN NAME OF

John E. O'Neal

Surveyed March 5, 1969, by D. C. Hendrix...