


T.18 S. R.5 W.W. M.

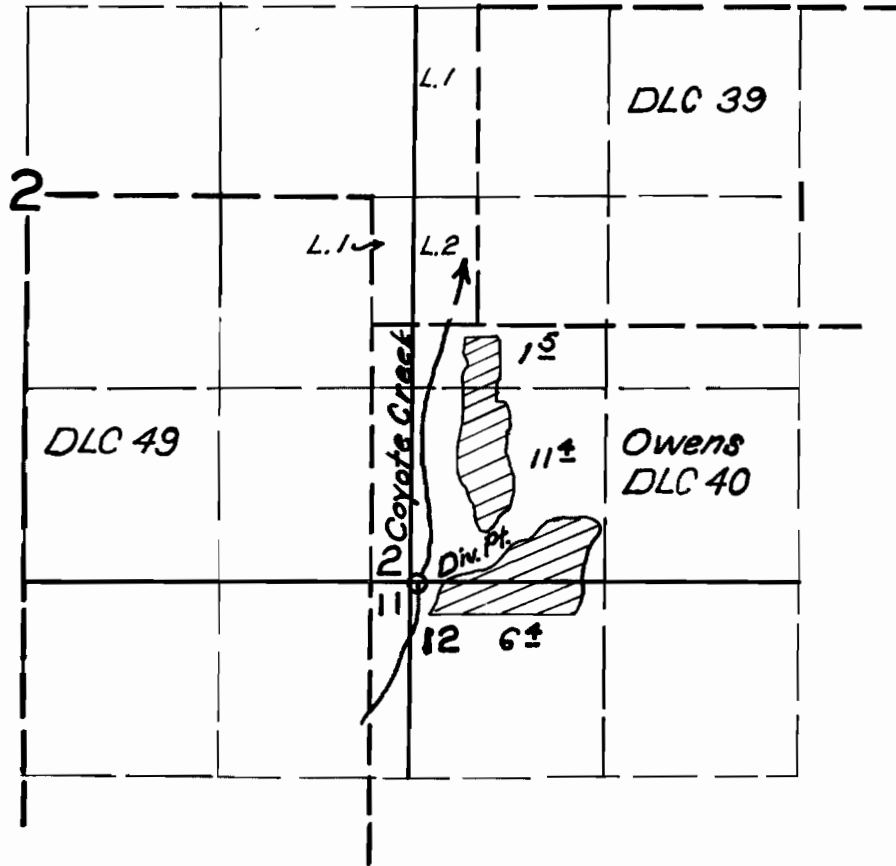

**FINAL PROOF SURVEY**  
UNDER

Application No. 32198 Permit No. 25411  
IN NAME OF

Leo J. Nielsen

Surveyed 9 May 1962, by Carl R. Baker