


TWP. 31 & 32 S. RGE. 41 & 42 E.

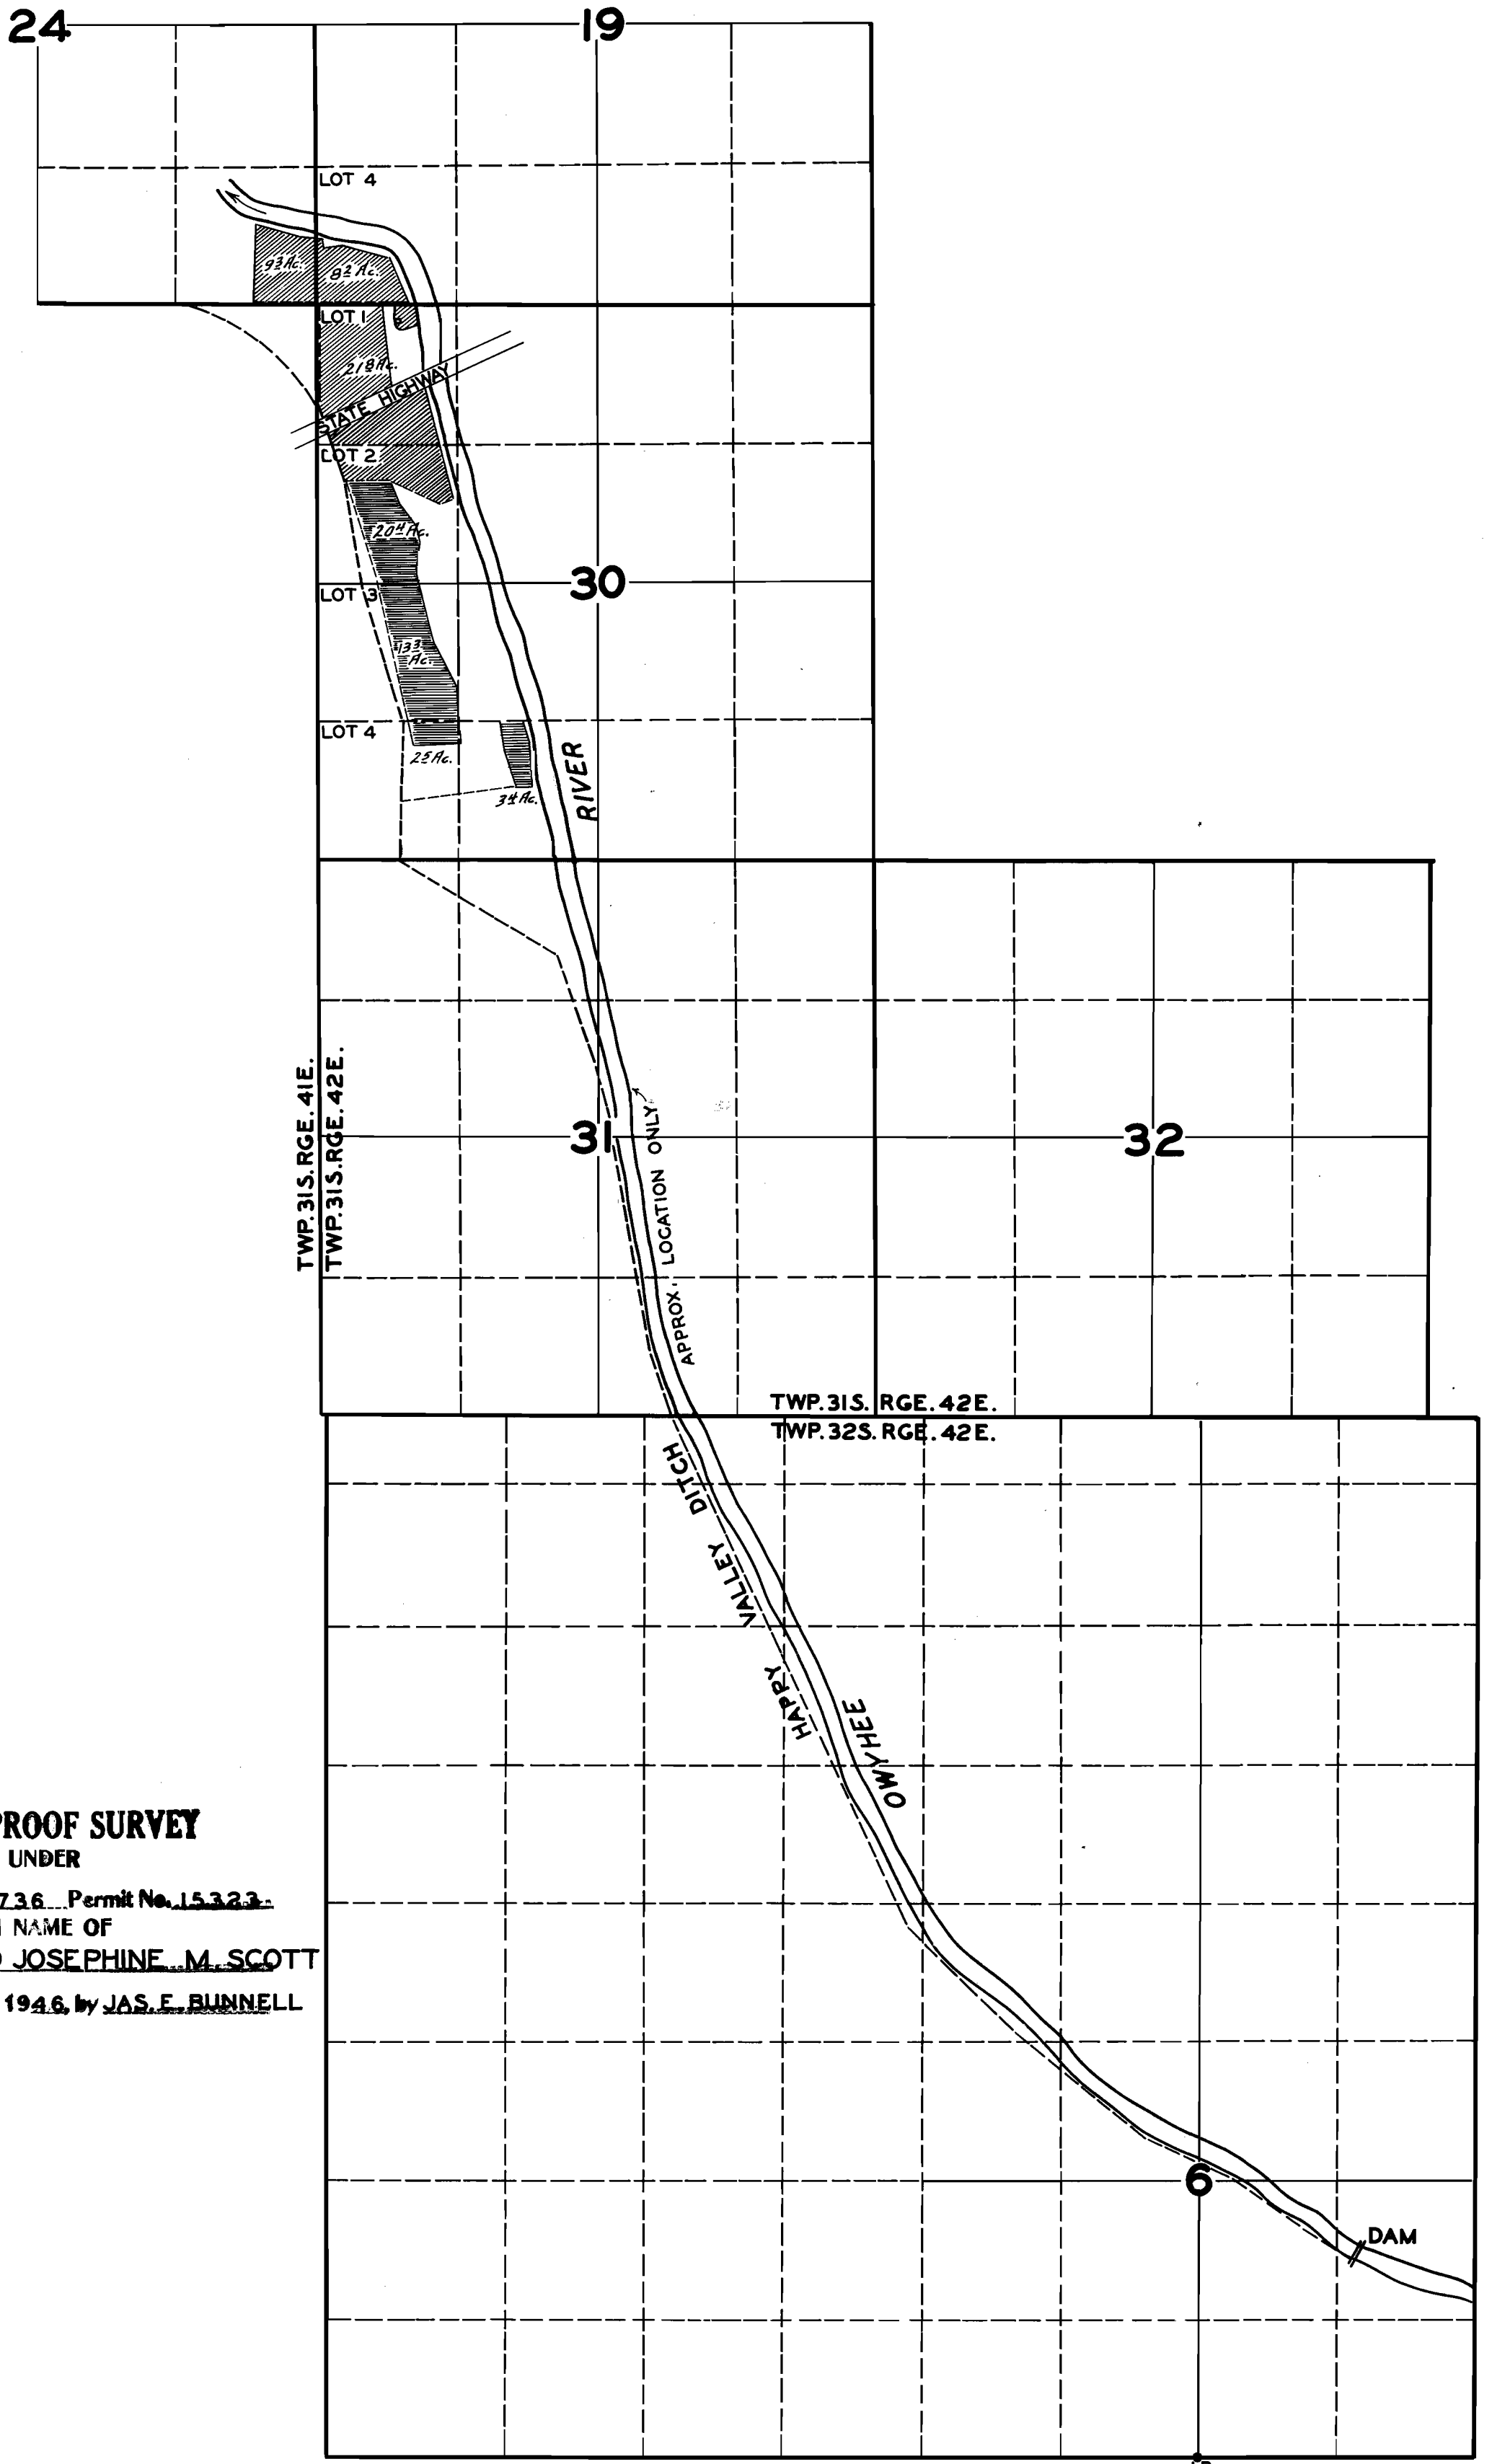

FINAL PROOF SURVEY
UNDER
Application No. 19736 Permit No. 15323
IN NAME OF
FRED SCOTT AND JOSEPHINE M. SCOTT
Surveyed MAY 30 1946, by JAS. E. BUNNELL