


T.9S. R.40E. W.M.

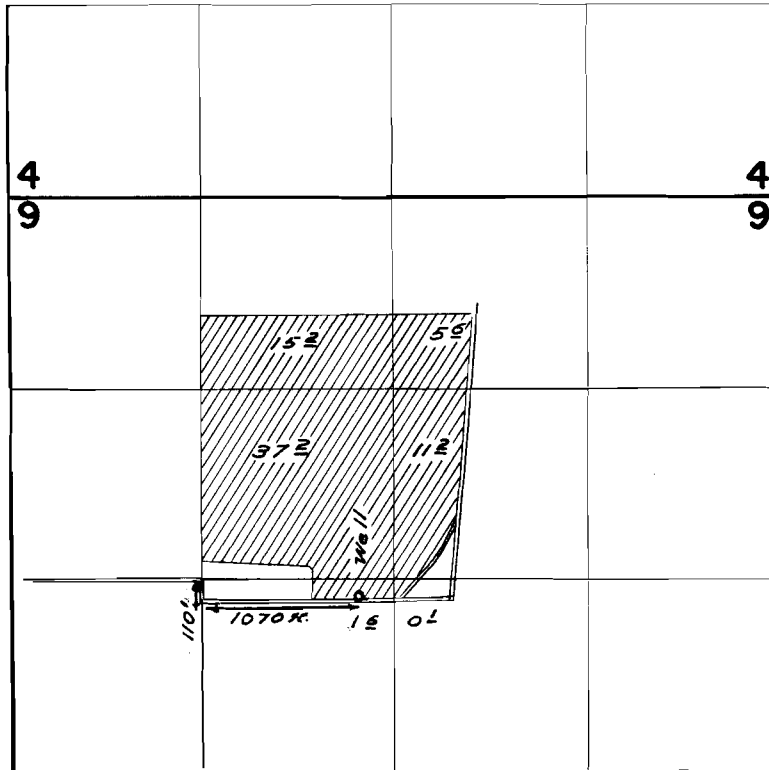

FINAL PROOF SURVEY
UNDER

Application No. G-2909 Permit No. G-2688
IN NAME OF

Mrs. Emma Baird

Surveyed Aug 9 1966, by W. J. Ryland