


T.26S.R.13W.W.M.

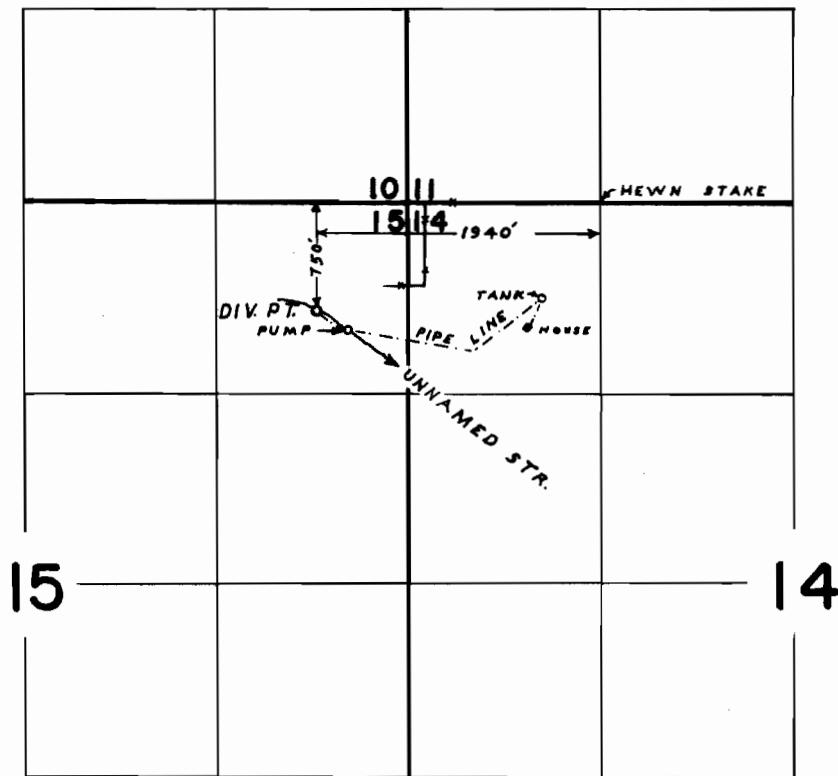

FINAL PROOF SURVEY
UNDER

Application No. 43492 Permit No. 32530
IN NAME OF

COOS LAND FILL INCORPORATED

Surveyed **SEPT. 18, 1968**, by **L. E. GOULD**