


T.26S. R.4W. W.M.

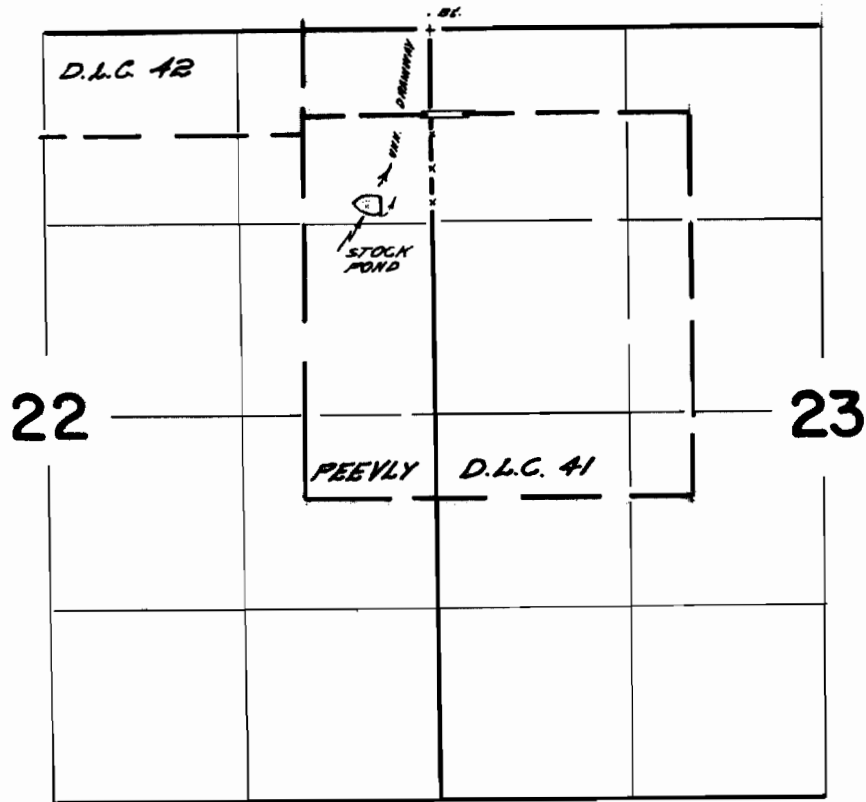

FINAL PROOF SURVEY
UNDER

Application No. *A-13532* Permit No. *P-5000*
IN NAME OF

C. H. BILLETER

Surveyed *date 28* 1968, by *W. D. Ruppert*