


T.32S. R.5W.W.M.

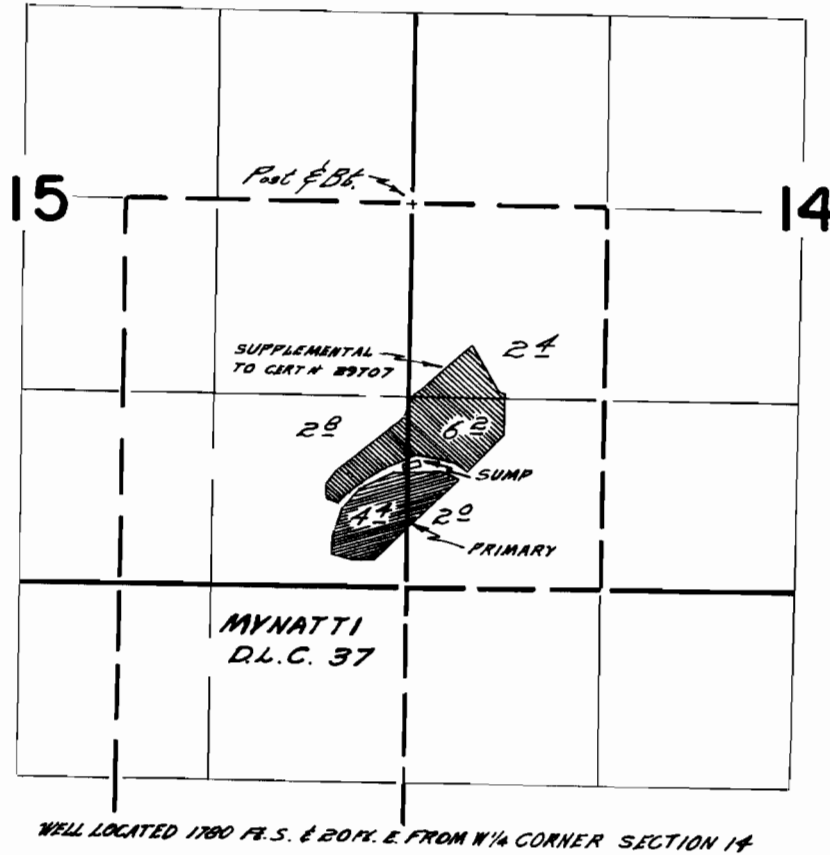

FINAL PROOF SURVEY
UNDER

Application No. *G-2508*. Permit No. *G-2317*
IN NAME OF

LOUIS BRADY

Surveyed *May 2*, 1968, by *W. O. Hupperts*