


T. 32 S. R. 5 W. W.M.

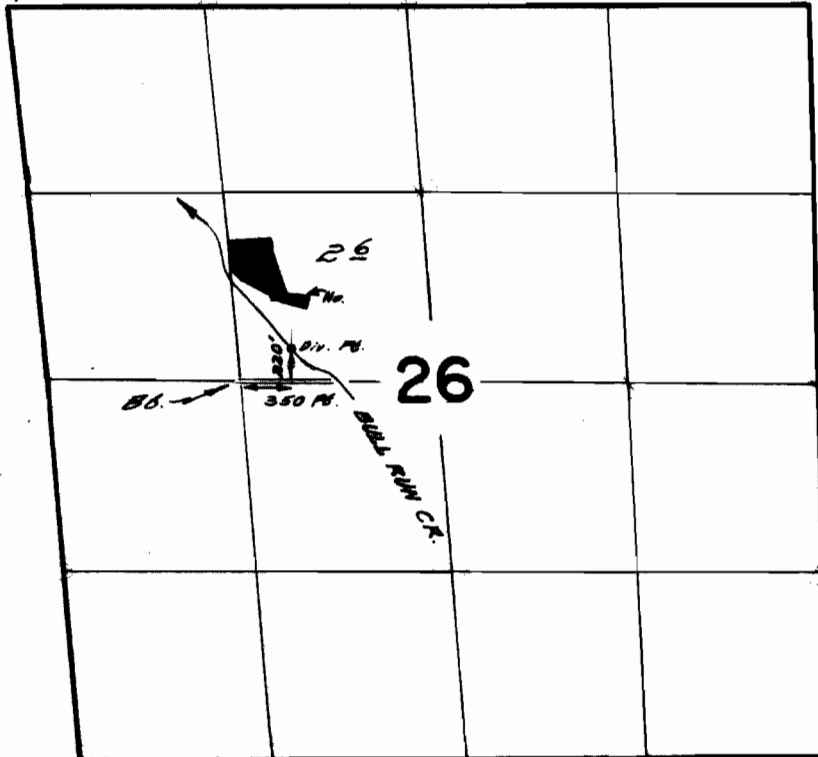

FINAL PROOF SURVEY
UNDER

Application No. 34272 Permit No. 26970
IN NAME OF

JOHN A. HALL

Surveyed May 1 1968, by W. d. Ruppert