


T. 31 S. R. 4 W. W.M.

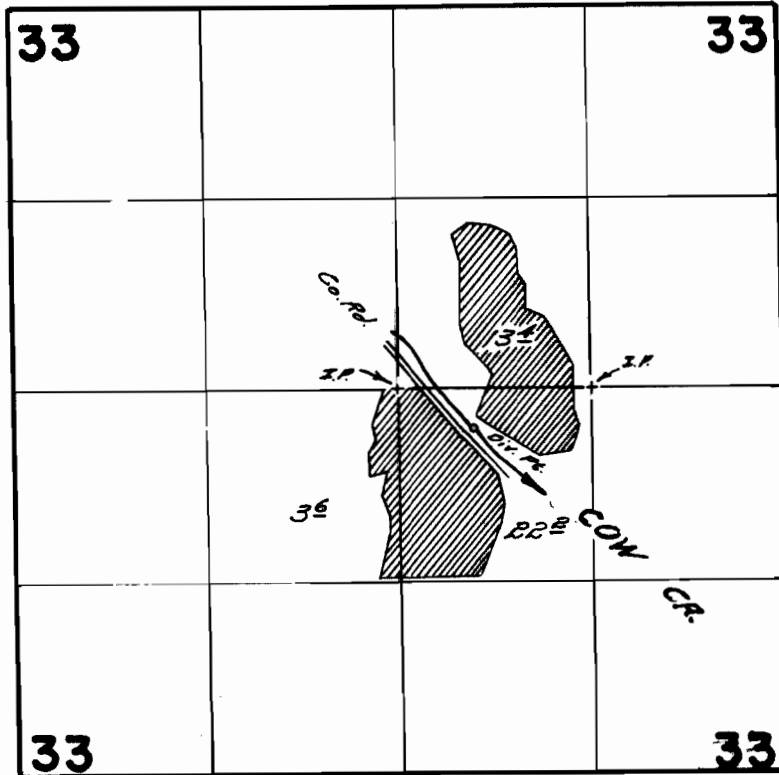

DIVERSION POINT LOCATED 200 F.S. ± 580 F.S. E. FROM  
CENTER 1/4 CORNER SECTION 33

**FINAL PROOF SURVEY**  
UNDER

Application No. 35526 Permit No. 27501  
IN NAME OF

ROSS M. LENT

Surveyed April 28, 1968, by N.d. Ruppert