


T.23S.R.4W.W.M.

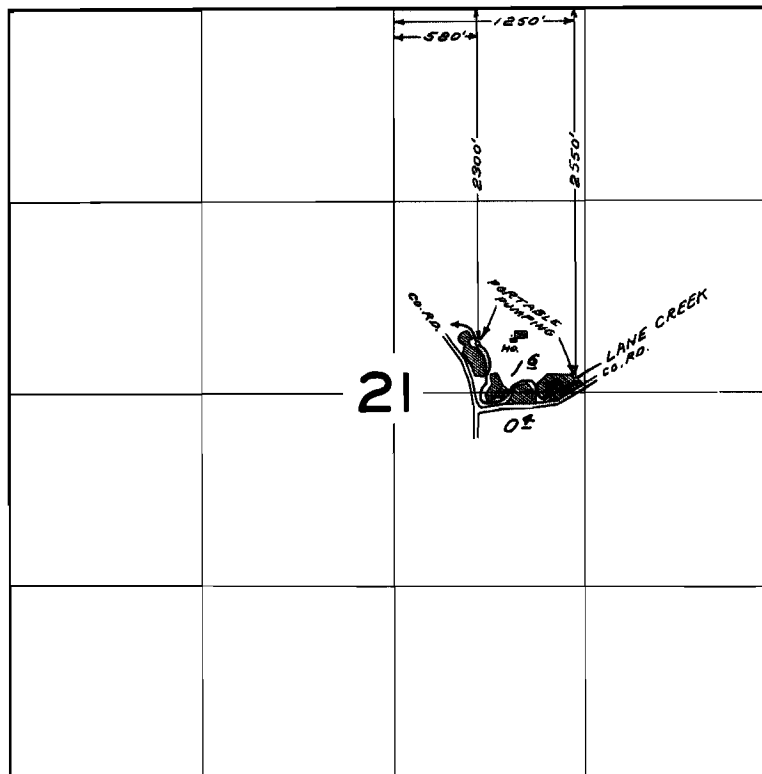

FINAL PROOF SURVEY
UNDER

Application No. 38390 Permit No. 28605
IN NAME OF

WALTER H. AND SYLVIA F. MEIER

Surveyed APR. 30 1968, by V. GARNER