


T.21S.R.4W.W.M.

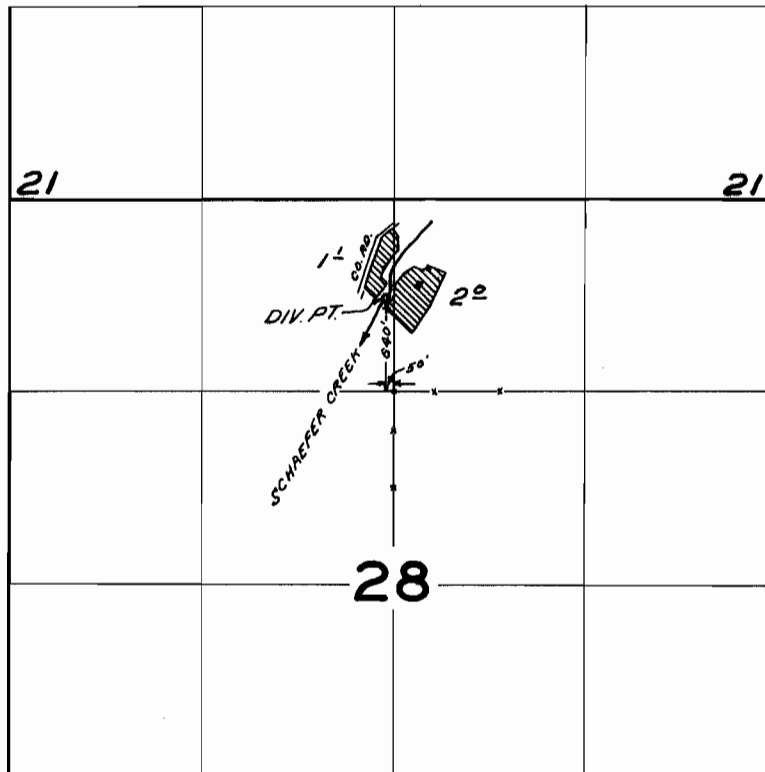

FINAL PROOF SURVEY
UNDER

Application No. 38712 Permit No. 28826
IN NAME OF

CHARLES W. BOOHER

Surveyed MAY 3 1968, by V. GARNER