


T.29S. R.7W. W.M.

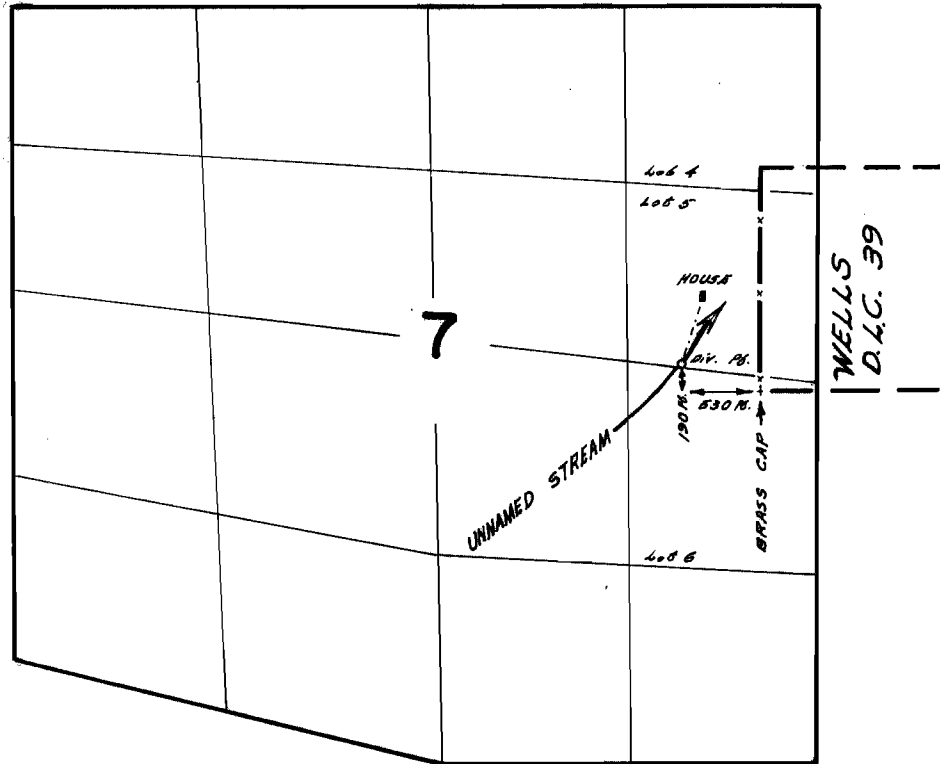

FINAL PROOF SURVEY
UNDER

Application No. 39058 Permit No. 29081
IN NAME OF

S. A. LAURANCE

Surveyed June 26 1968, by W. C. Ruppert