


T.32S. R.4&5W.W.M.

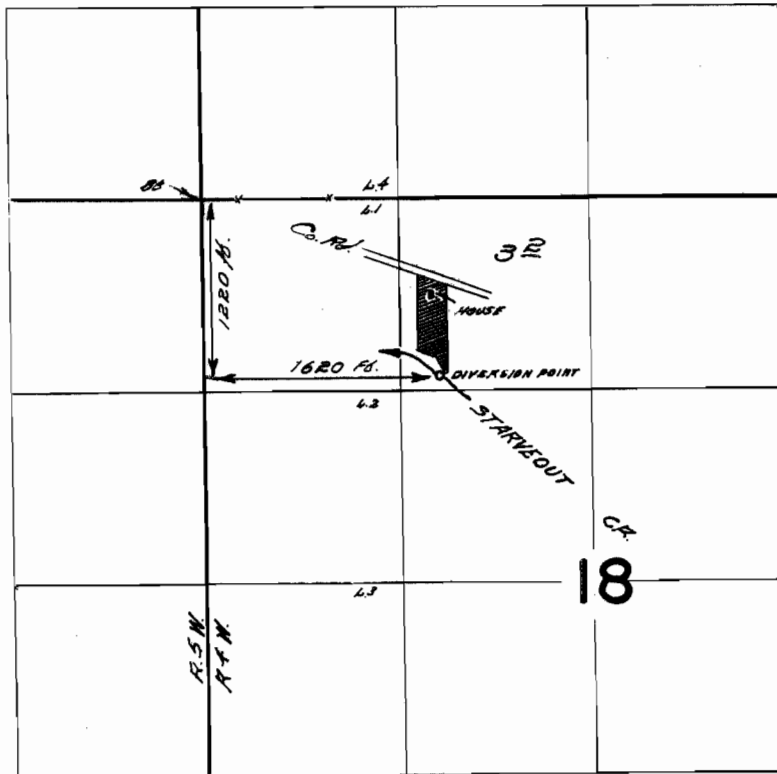

FINAL PROOF SURVEY UNDER

Application No. 39006 Permit No. 29210
IN NAME OF

FRANK KOPEJTKO

Surveyed May 1 1968, by W. J. Haggerty