


# T. 29 S. R. 7 W. W.M.

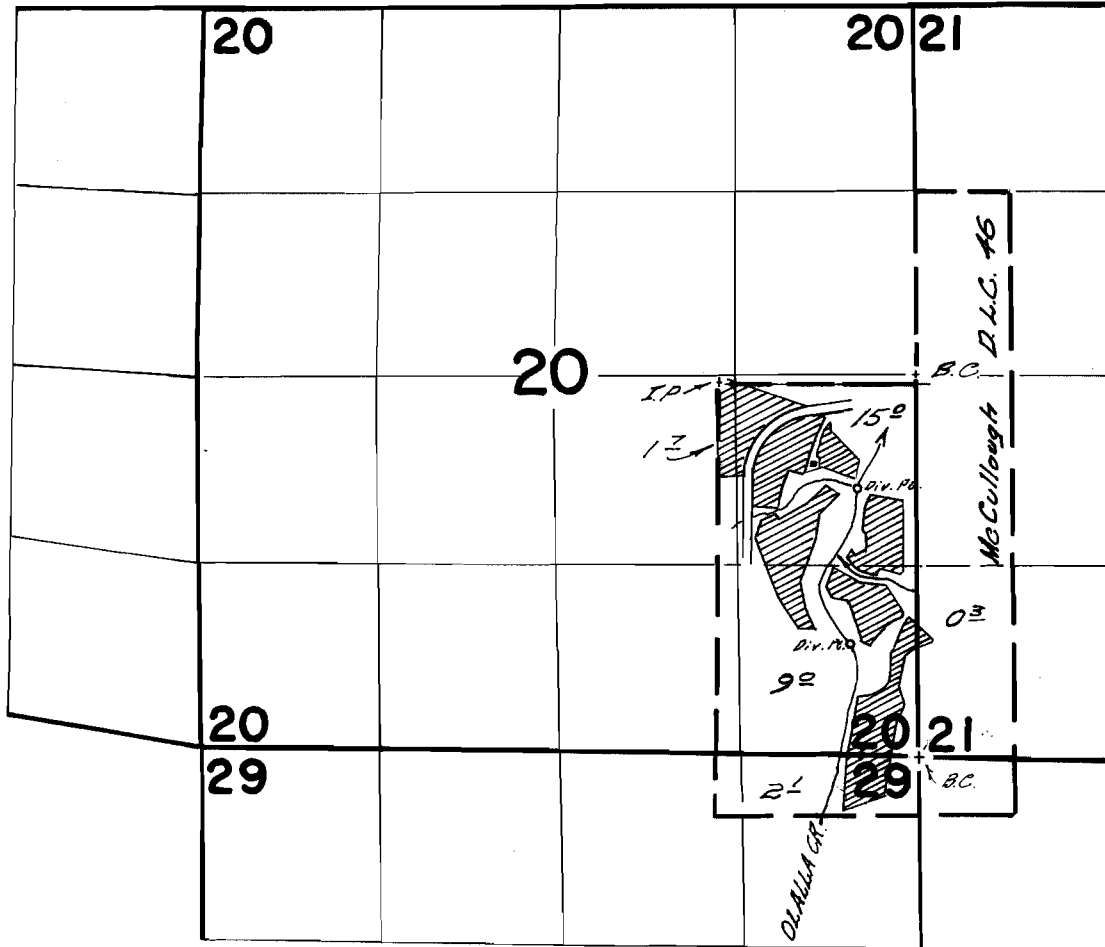

Diversion point points located 720 Ft. S. & 950 Ft. W.; & 1780 Ft. S. & 910 Ft. W. from most westerly N.W. cor. D.L.C. 46.

## FINAL PROOF SURVEY UNDER

Application No. 40125 Permit No. 29913  
IN NAME OF

A. J. ANDERSON

Surveyed Sept. 28 1967, by W. J. Ruppert  
June 25, 1968