


T. 30 S. R. 2 W. W.M.

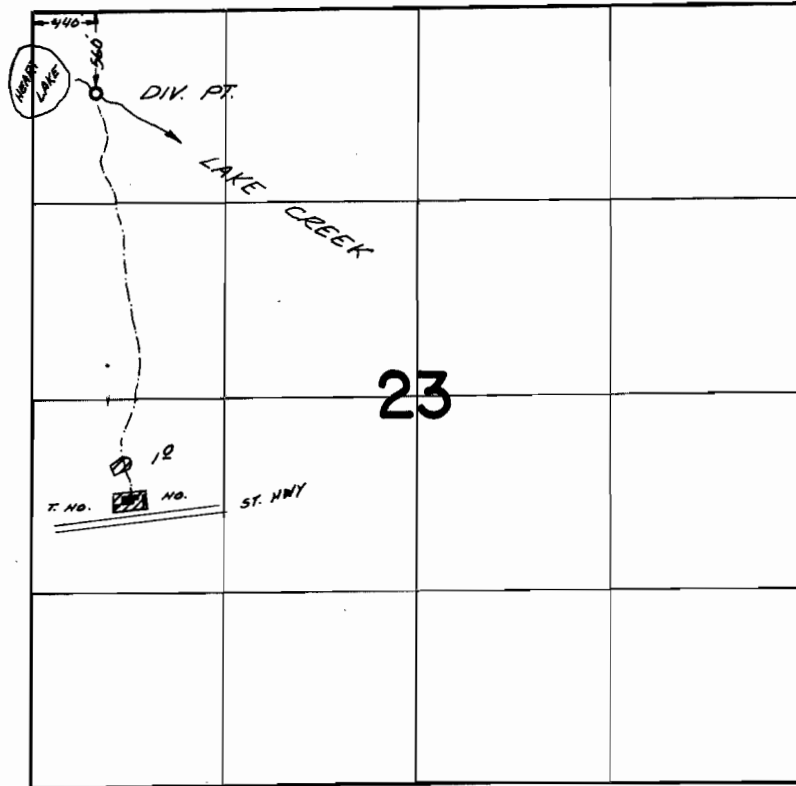

FINAL PROOF SURVEY
UNDER

Application No. 40451 Permit No. 30153
IN NAME OF

MILTON H. HAMMERSLY

Surveyed April 17, 1968, by V. Garner