


T. 22 S. R. 6 W. W.M.

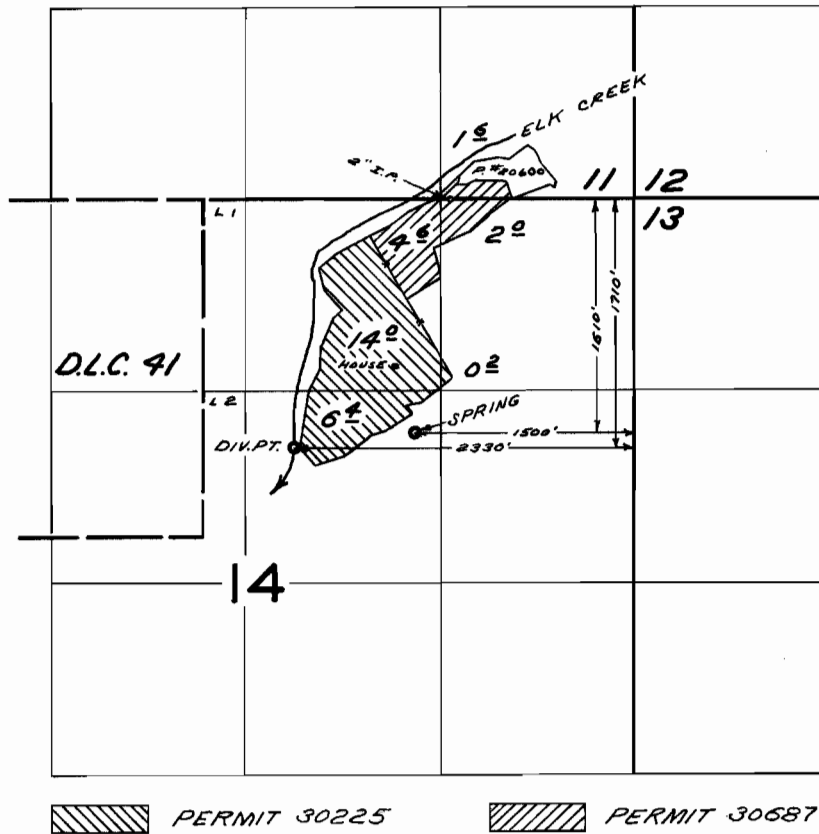

FINAL PROOF SURVEY
UNDER

Application No. 40564 Permit No. 30225
41162 Permit No. 30687
IN NAME OF

ED JONES

Surveyed MAY 2 1968, by V. GARNER