


T. 22 S. R. 7 & 8 W. W.M.

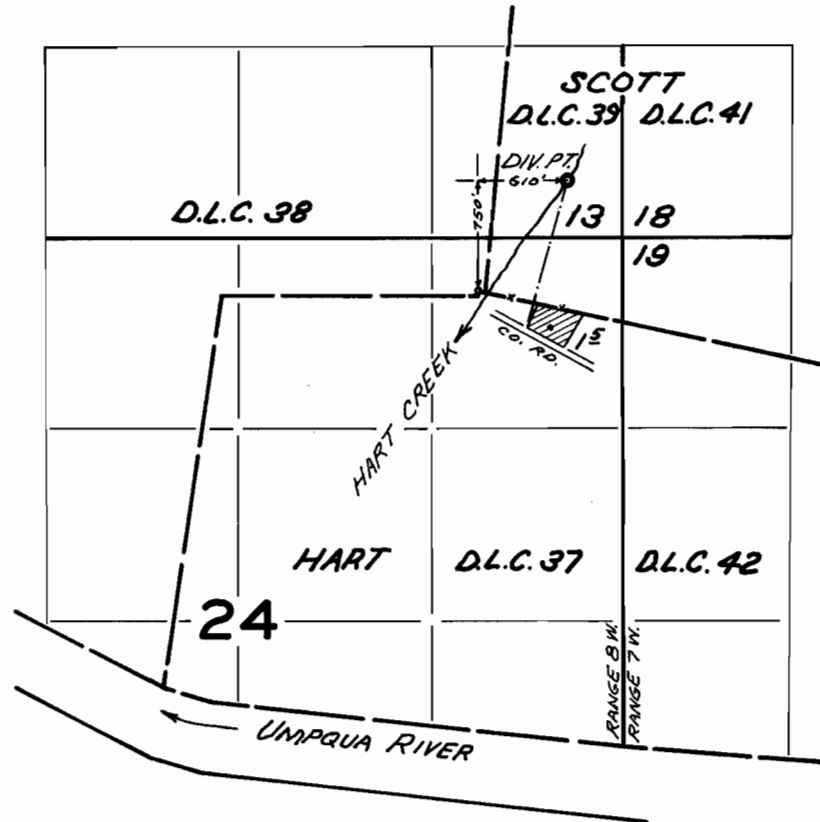

FINAL PROOF SURVEY  
UNDER

Application No. 40585 Permit No. 30238  
IN NAME OF

ANDREW S. LARSEN

Surveyed APR. 29 1968, by V. GARNER