


T.32 S. R.4 & 5 W.W.M.

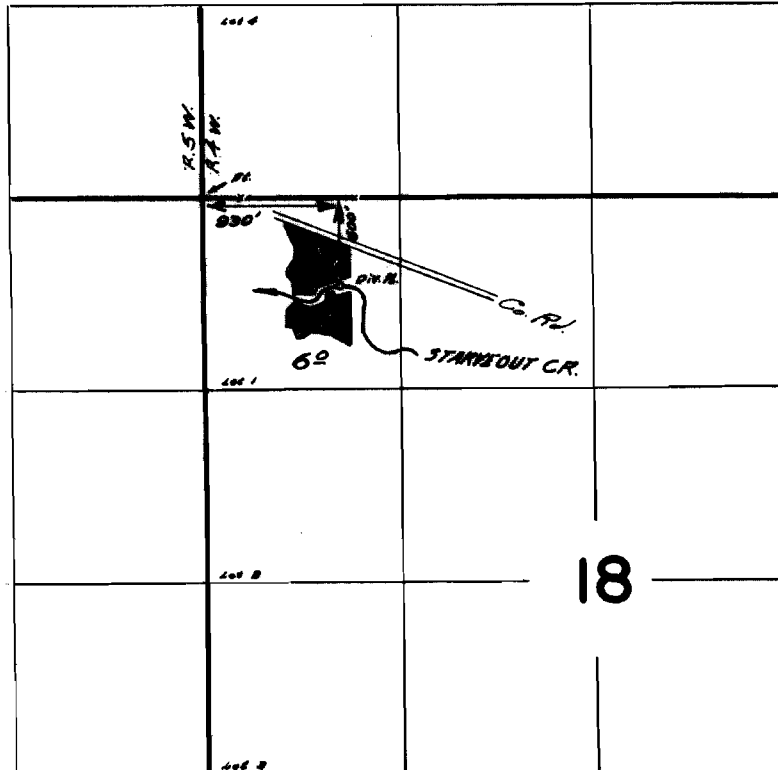

FINAL PROOF SURVEY
UNDER

Application No. *40879* Permit No. *30472*
IN NAME OF

THOMAS V. WILKINS

Surveyed *May 1*, 1968, by *W.J. Koppert*