T.22S.R.6W.W.M.

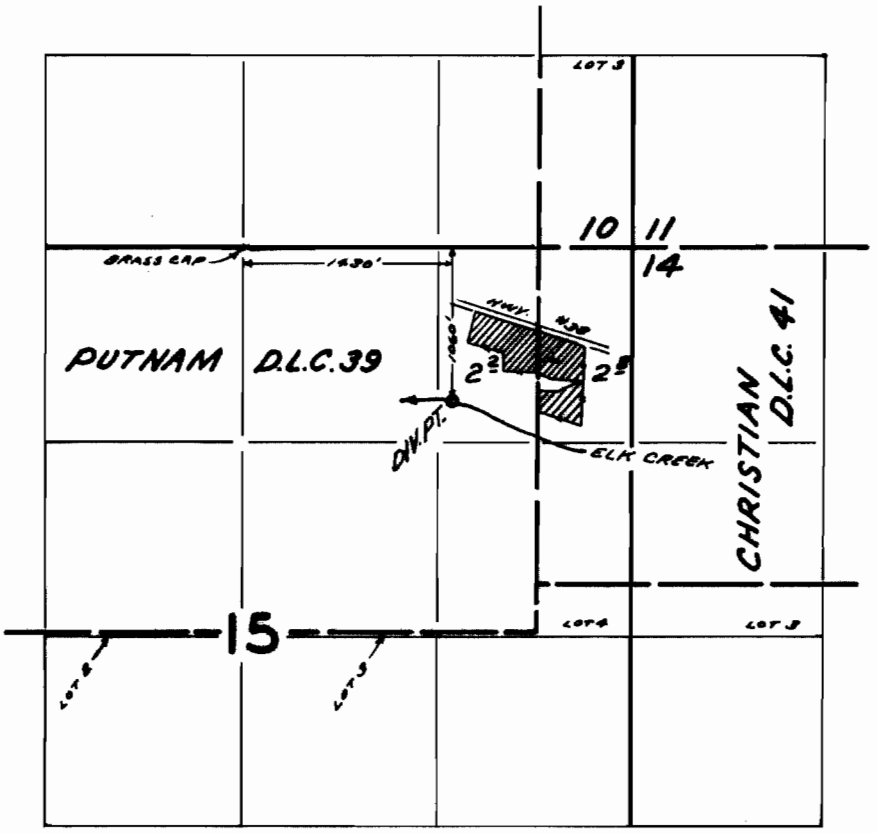

FINAL PROOF SURVEY
UNDER

Application No. 41250 Permit No. 30761
IN NAME OF

HAROLD WOOLLEY

Surveyed MAY 1 19 68, by V. GARNER