


T.29S. R.7 W. W.M.

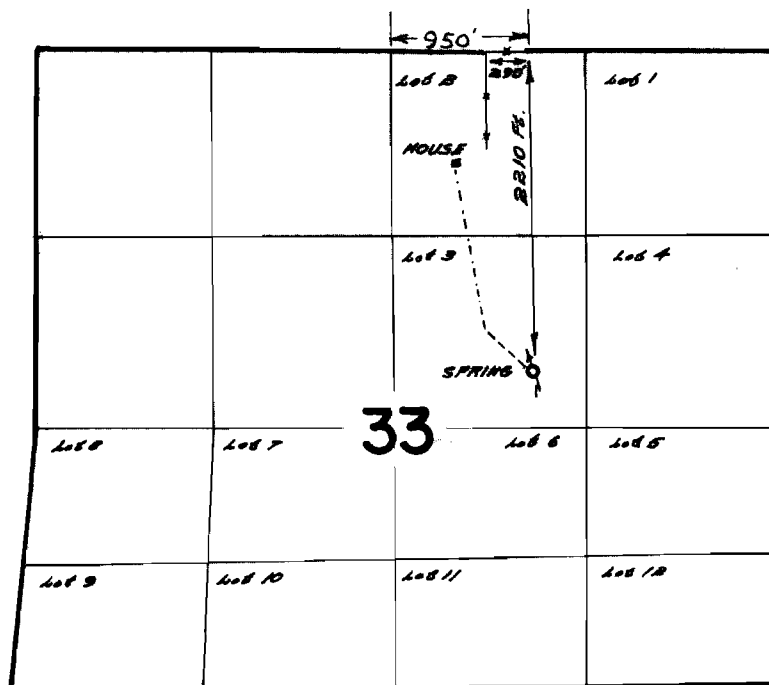

FINAL PROOF SURVEY
UNDER

Application No. 41858 Permit No. 31218
IN NAME OF

EVANGELINE BAKER

Surveyed June 25 1968, by W. L. Ruppert