


T.22S.R.8W.W.M.

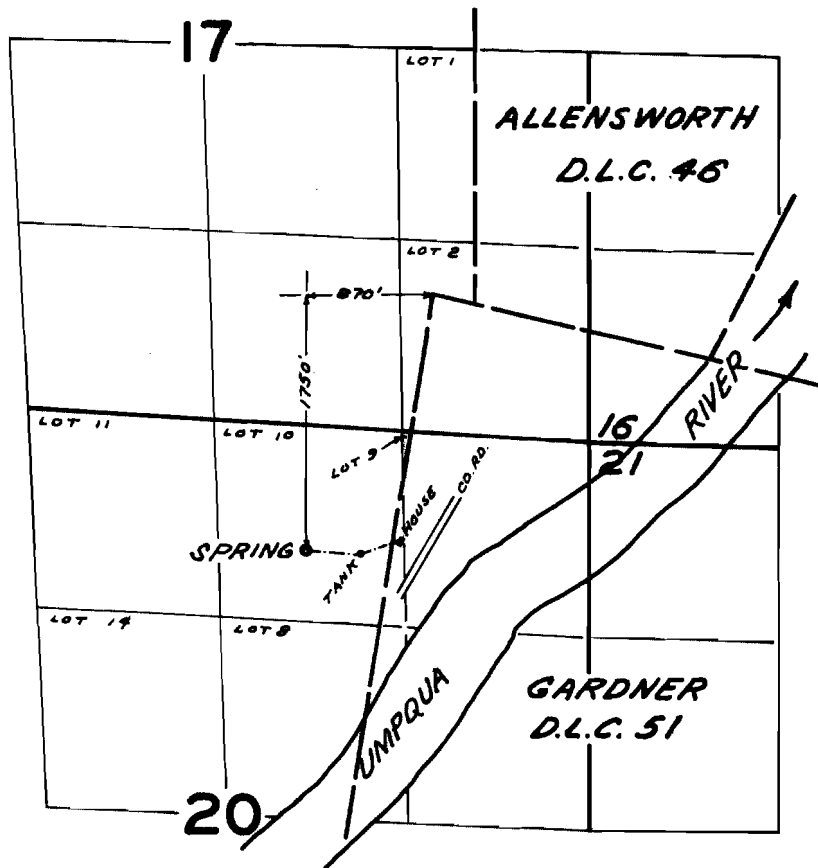

FINAL PROOF SURVEY
UNDER

Application No. 41869 Permit No. 31325
IN NAME OF

RAYMOND MONNER

Surveyed JUL. 11, 1967 by V. GARNER
APR. 29, 1968