


T.28 S. R.7 W. W.M.

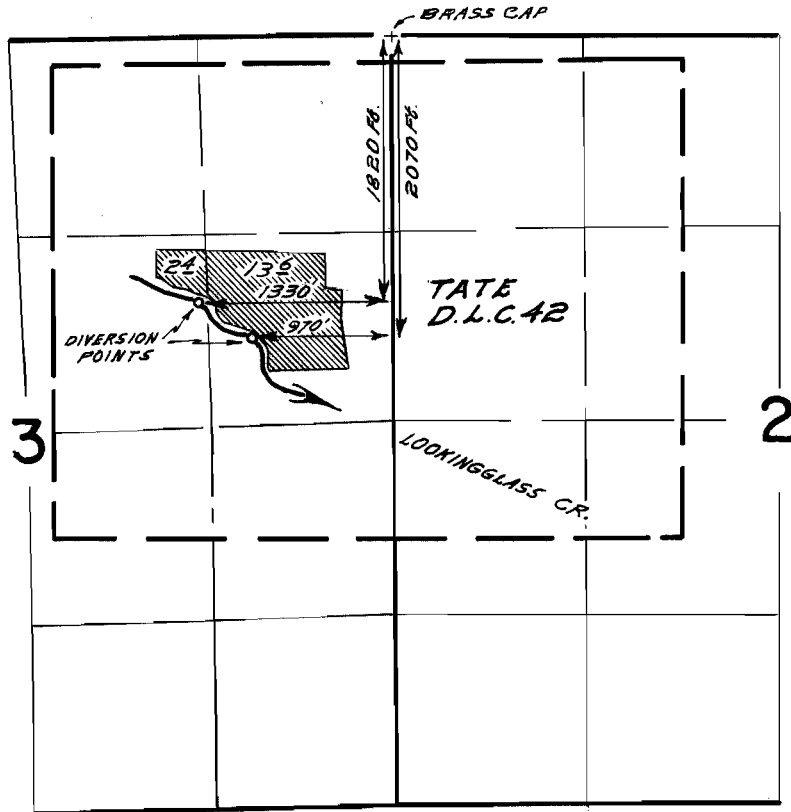

FINAL PROOF SURVEY  
UNDER

Application No. 42246 Permit No. 31584  
IN NAME OF

*IVAN M. MATTHEWS*

Surveyed July 13, 1967, by *W. d. Ruppert*  
date 24, 1968