


T.22S.R.6W.W.M.

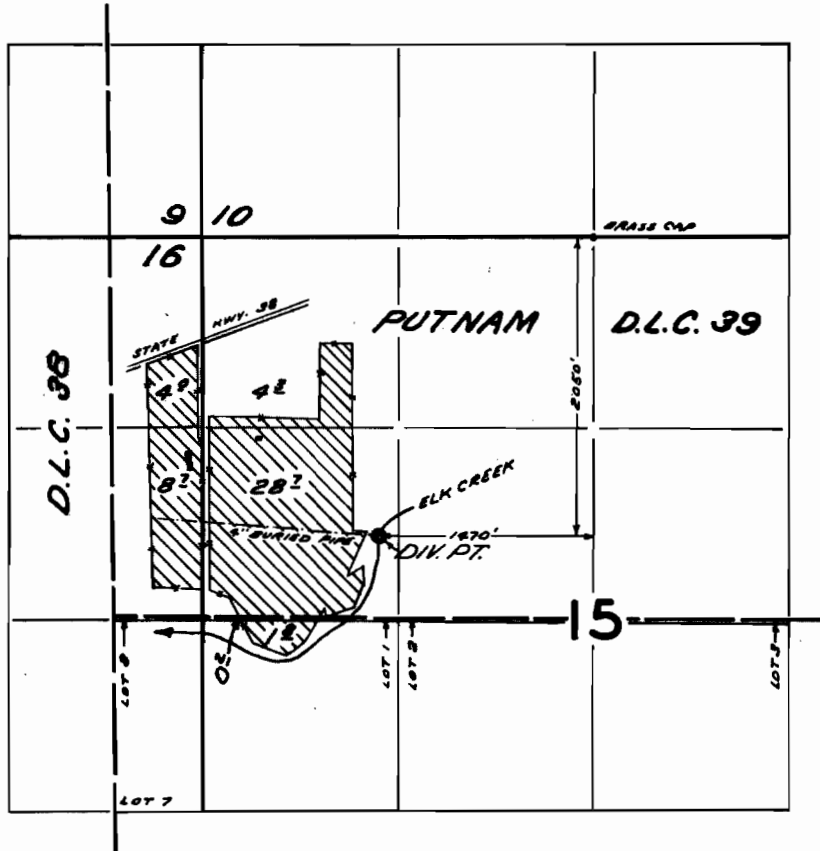

FINAL PROOF SURVEY
UNDER

Application No. 42443 Permit No. 31754
IN NAME OF

STACY L. JOHNSON

Surveyed MAY 1 1968, by V. GARNER