


T.26S.R.3W.W.M.

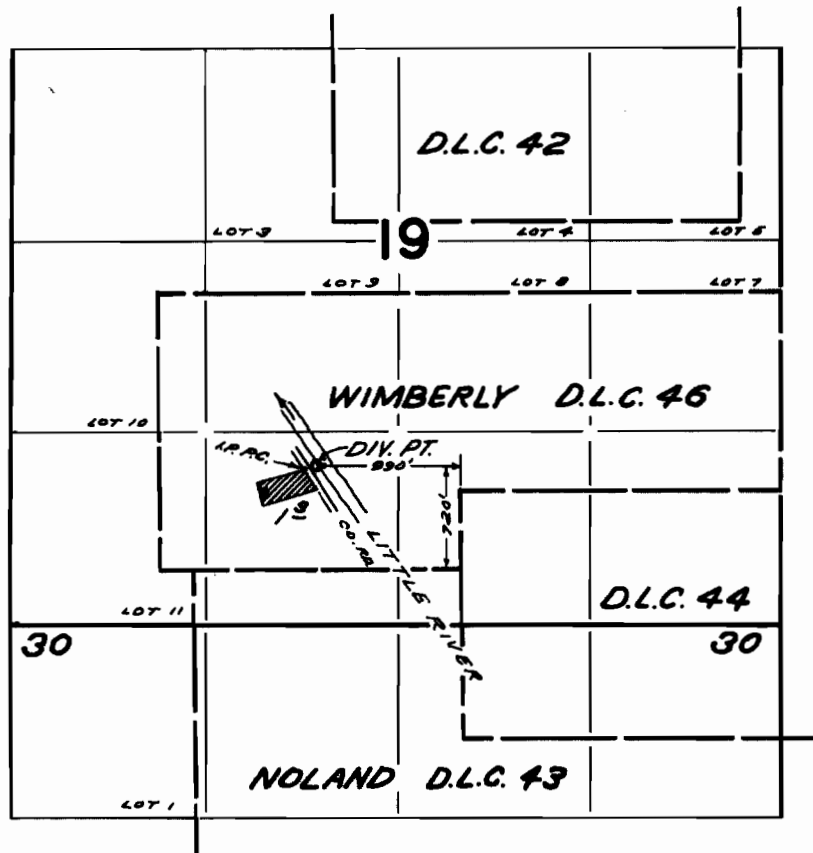

FINAL PROOF SURVEY
UNDER

Application No. 42462 Permit No. 31759
IN NAME OF

CARL & MARY RYDBERG

Surveyed OCT 3 1968, by V. GARNER