


# T. 26 S. R. 3 W. W.M.

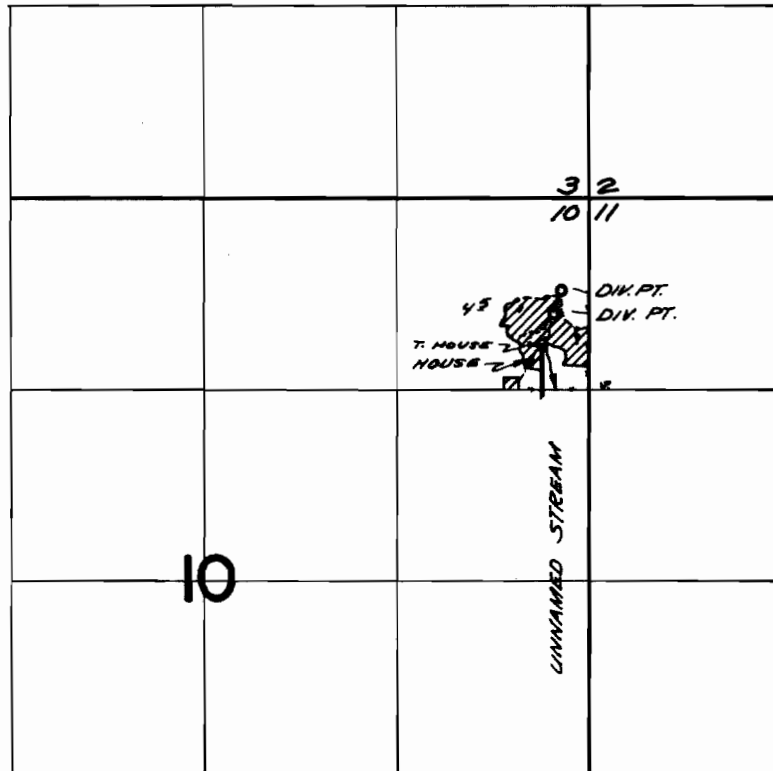

DIV. PTS. LOCATED 680 FT. N. & 180 FT. W. ; 520 FT. N. & 240 FT. W. BOTH FROM THE SE COR. NE 1/4 NE 1/4 SECTION 10

## FINAL PROOF SURVEY UNDER

Application No. 42525 Permit No. 31779  
IN NAME OF

CARL HELMS

Surveyed Oct. 3, 1968, by V. Garner