


T.32S. R.4W. W.M.

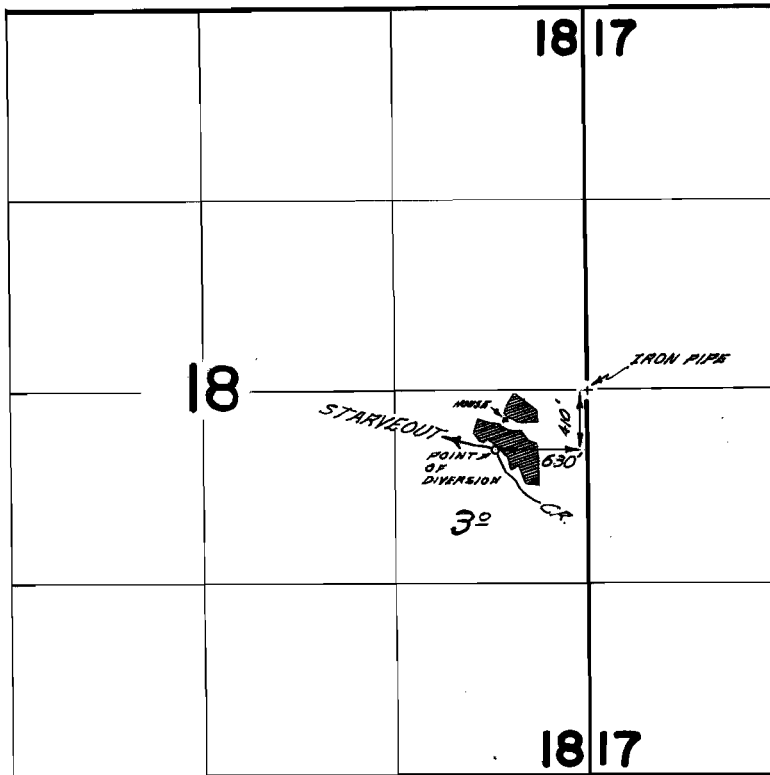

FINAL PROOF SURVEY
UNDER

Application No. *42936* Permit No. *32080*
IN NAME OF

WILLIAM M. CRIPPEN

Surveyed *April 30 1968*, by *W.T. Rupperts*