


T.32S. R.5W. W.M.

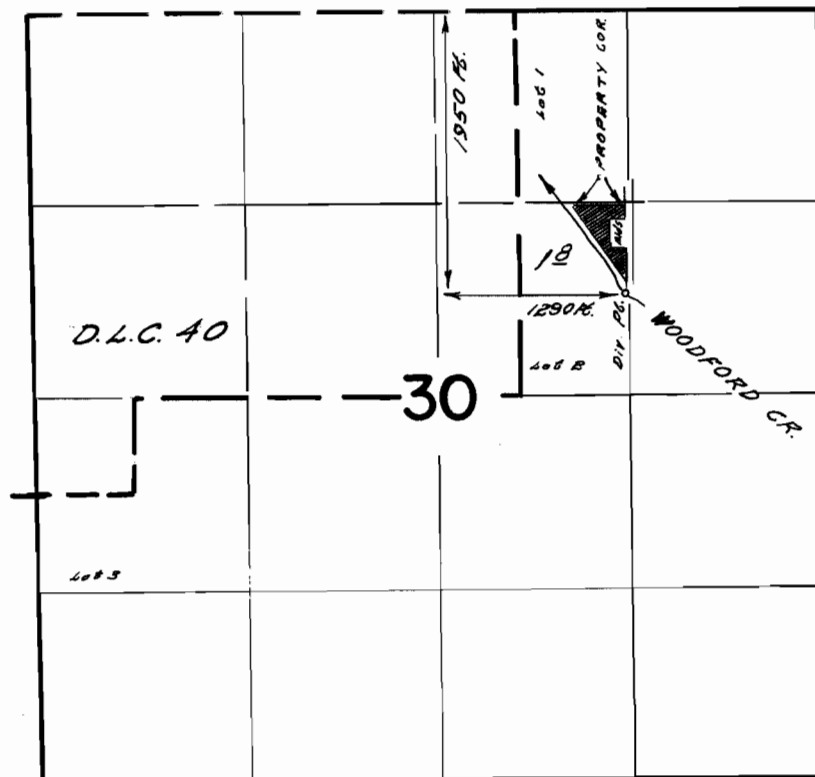

**FINAL PROOF SURVEY**  
UNDER

Application No. 12980 Permit No. 32111  
IN NAME OF

EDWARD REDFIELD

Surveyed May 3 1968, by W. J. Ruppert