


T. 31 S. R. 1 & 2 W. W. M.

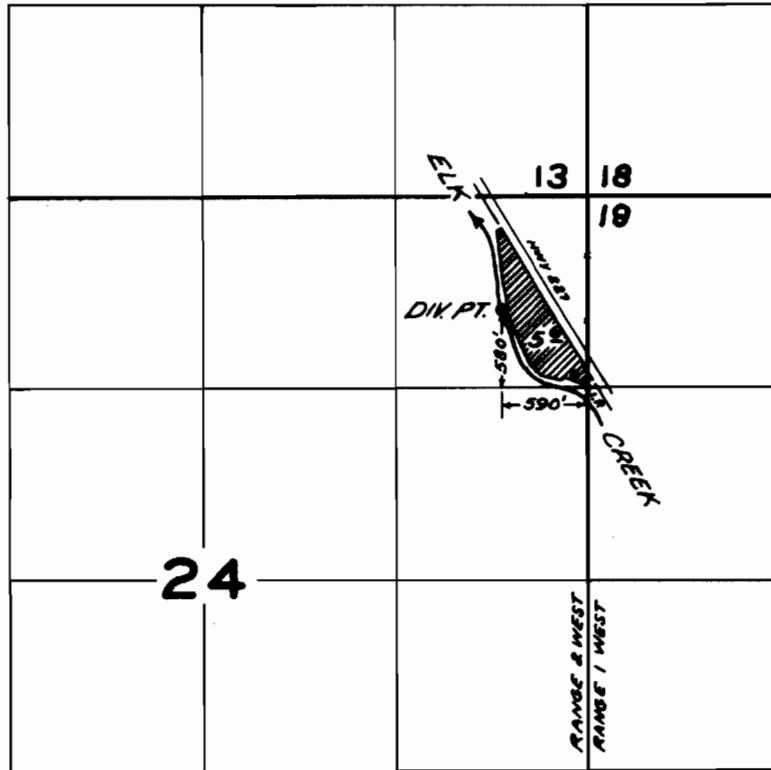

FINAL PROOF SURVEY
UNDER

Application No. 43401 Permit No. 32146
IN NAME OF

IVAN L. WILSON

Surveyed APR. 16 1968, by V. GARNER