


T. 30S. R. 3W. W.M.

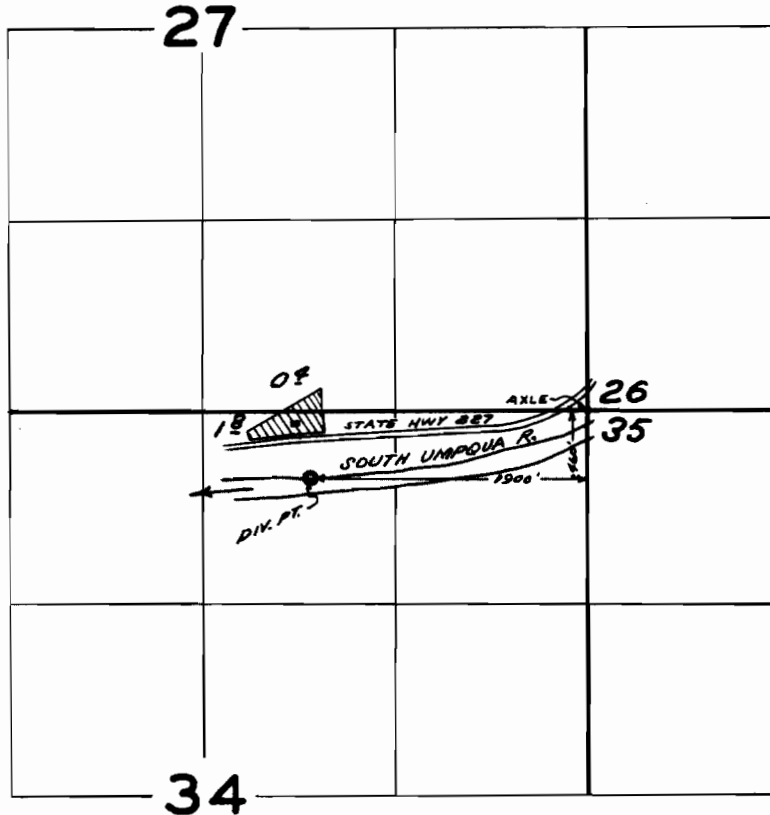

FINAL PROOF SURVEY
UNDER

Application No. 43259 Permit No. 32203
IN NAME OF

M. H. ENGLISH

Surveyed APR. 18 1968, by V. GARNER