


T.26S.R.4 W.W.M.

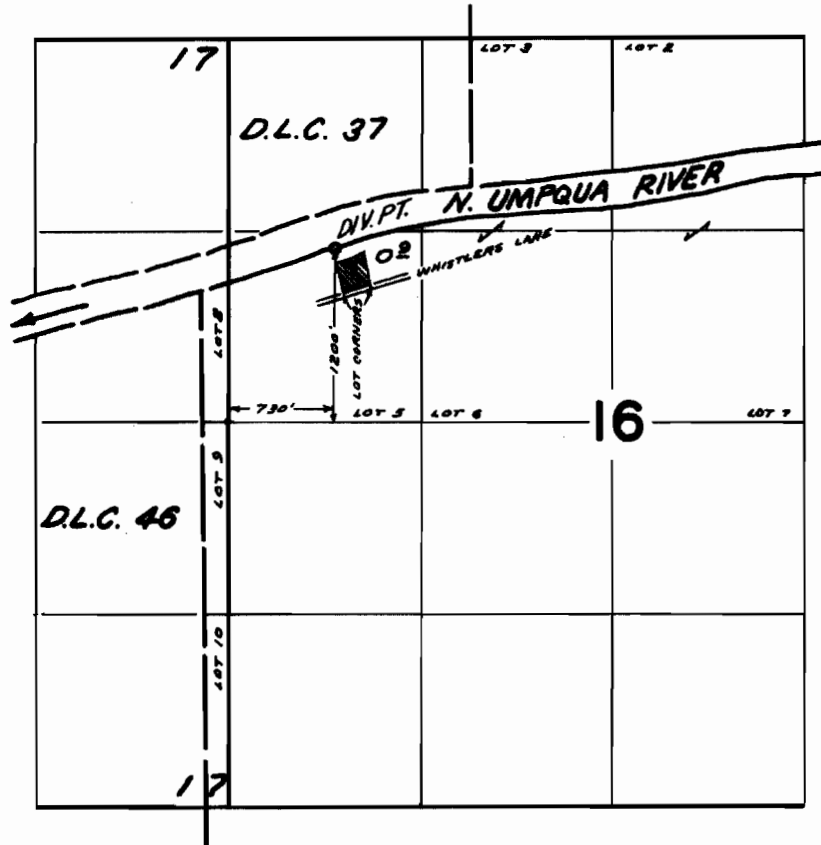

**FINAL PROOF SURVEY**  
UNDER

Application No. 43337 Permit No. 32393  
IN NAME OF

ROBERT D. AND GLADYS M. WILSON

Surveyed OCT. 3 1968, by V. GARNER