


T.32S. R.4 & 5W. W.M.

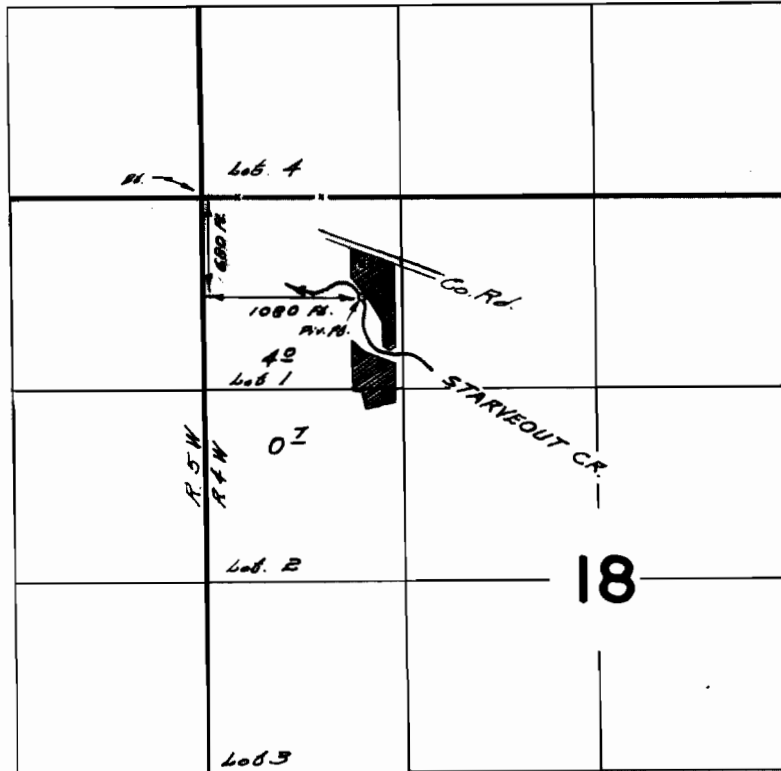

FINAL PROOF SURVEY
UNDER

Application No. 13504 Permit No. 32540
IN NAME OF

BERNARD T. & MAY B. BRADY

Surveyed May 1, 1968, by M. S. Rupperts