


T.26S.R.6W.W.M.

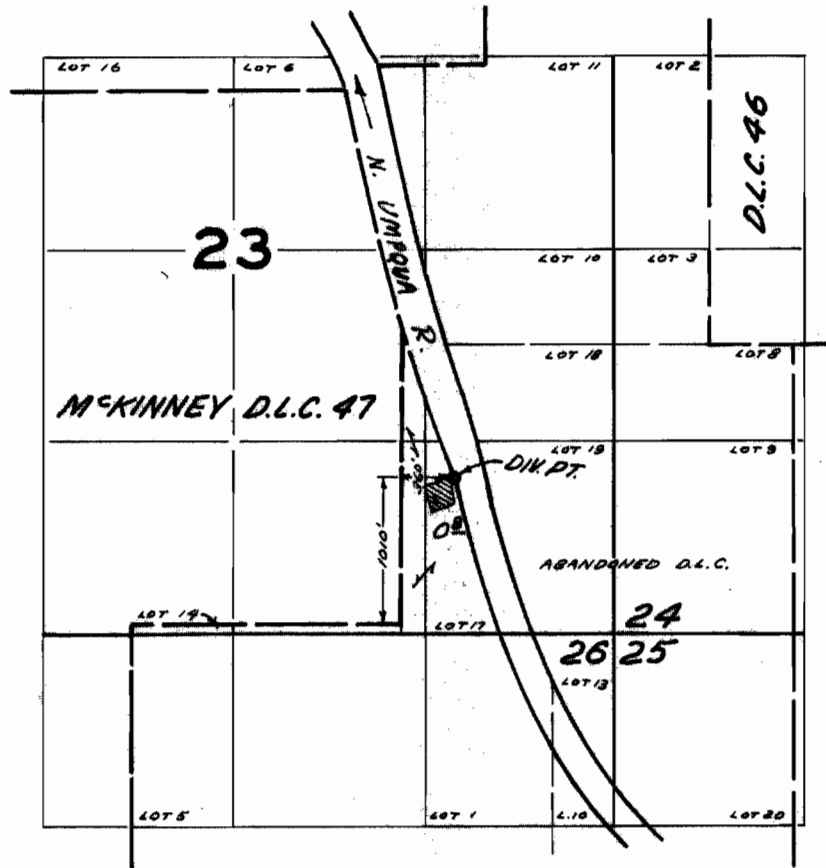

FINAL PROOF SURVEY
UNDER

Application No. 43828 Permit No. 32765
IN NAME OF

THEODORE F. MOUCHE

Surveyed OCT 1 1968, by V. GARNER