


T. 26 S. R. 6 W. W.M.

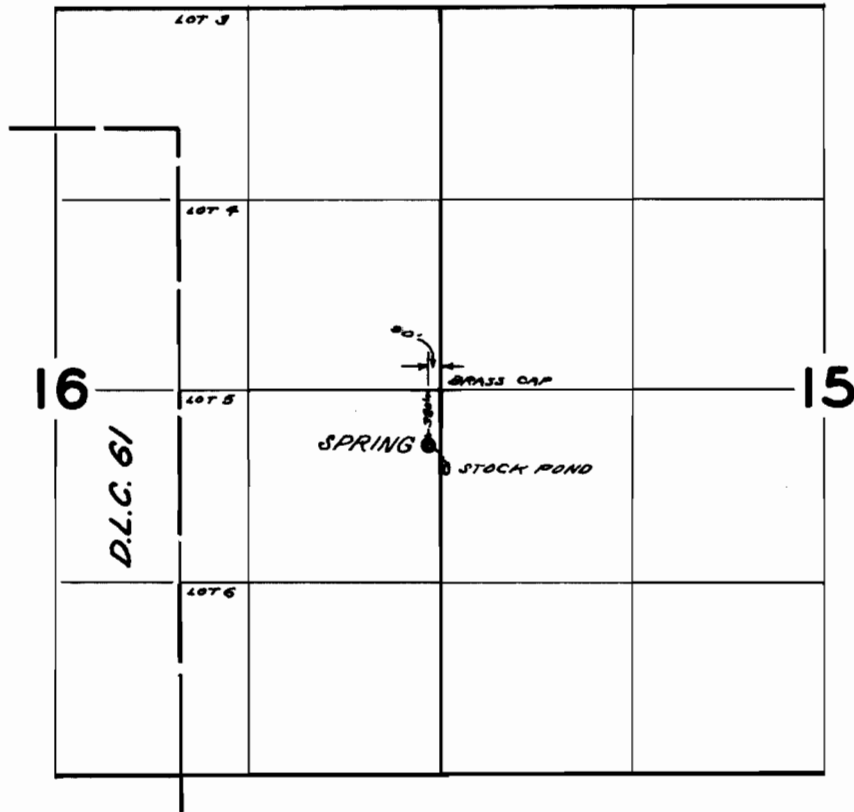

FINAL PROOF SURVEY
UNDER

Application No. 44304 Permit No. 33086
IN NAME OF

JAMES N. LARAUT

Surveyed OCT 1 1968, by V. GARNER