


T.35 S.R.4W.W.M.

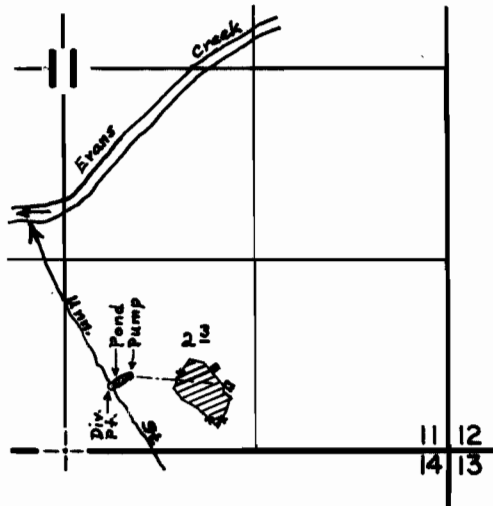

Diversion Point is located 450' N. & 320' E.
from the S 1/4 corner section 11.

FINAL PROOF SURVEY UNDER

Application No. 38022 Permit No. 28337
IN NAME OF

Peter M. and Ketura R. Riis

Surveyed March 14, 1969, by D. C. Hendrix