


T.21S.R.2W.W.M.

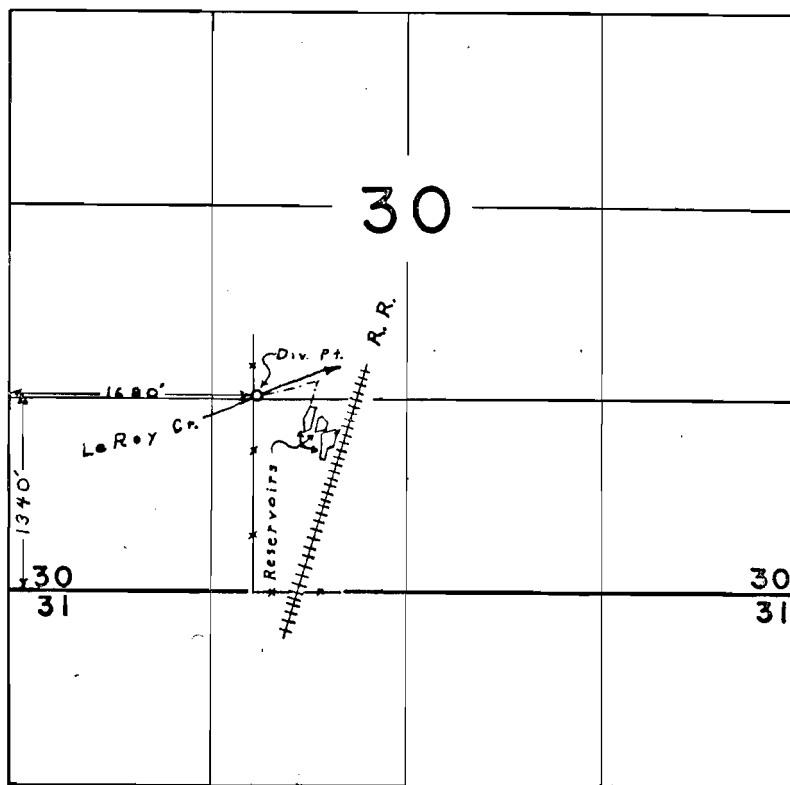

FINAL PROOF SURVEY  
UNDER

R-41135 R-4620  
Application No. 41136 Permit No. 30668  
IN NAME OF

A. L. HOUGHTALING

Surveyed OCT. 7, 1968, by L. E. GOULD