


T.19S.R.2&3W.W.M.

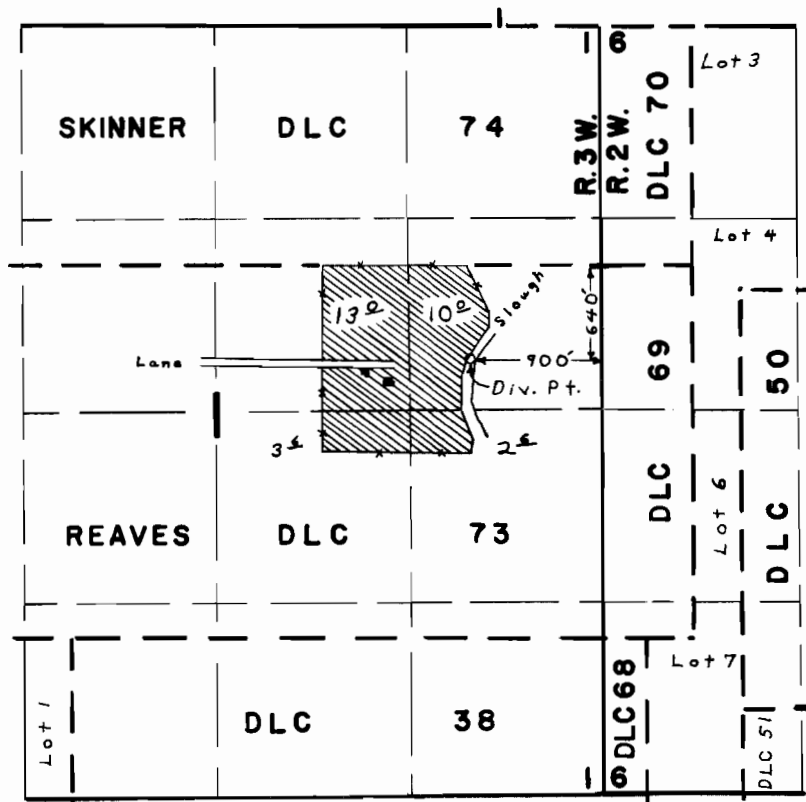

FINAL PROOF SURVEY UNDER

Application No. **41565** Permit No. **31006**
IN NAME OF

N. L. ALFORD

Surveyed **OCT. 8, 1968**, by **L. E. GOULD**