


T.6S. R.2W. W.M.

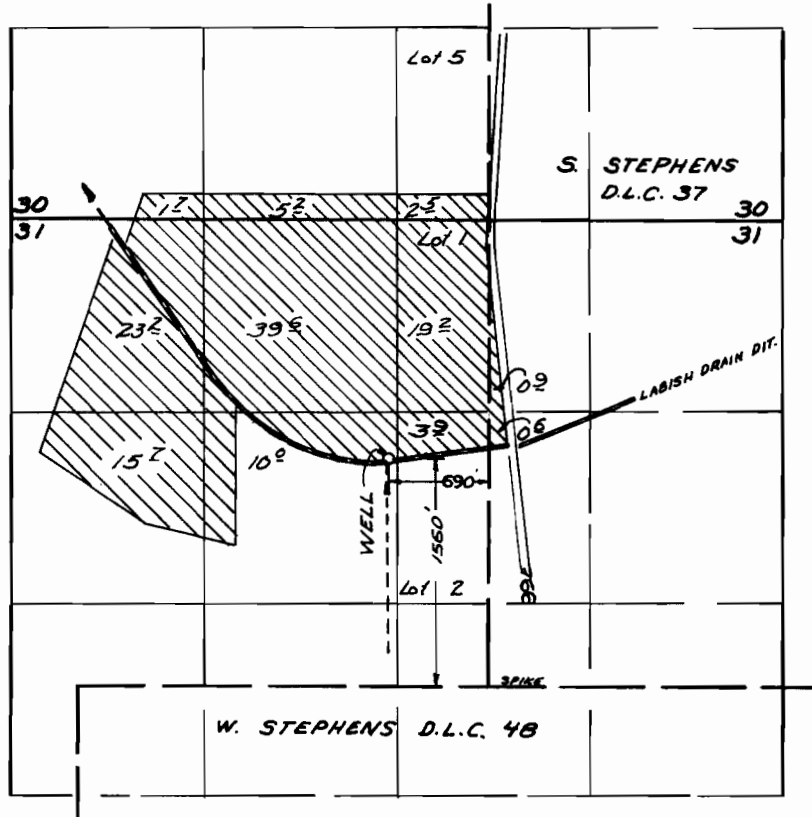

FINAL PROOF SURVEY
UNDER

Application No. G-2391... Permit No. G-2166.
IN NAME OF

URLIN S. and L. K. PAGE

Surveyed *April 10, 1968*, by *V. Garner*