


T.10S. R.2 W. W.M.

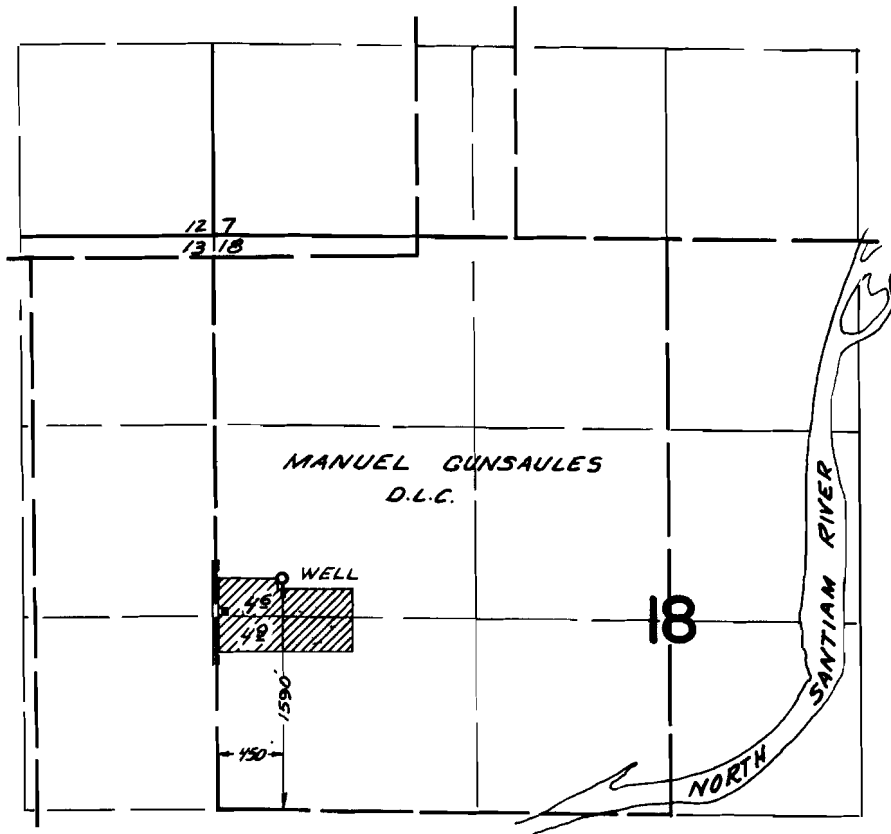

FINAL PROOF SURVEY
UNDER

Application No. G-2797 Permit No. G-2617
IN NAME OF

ARTHUR W. WINSLOW

Surveyed July 24, 1968, by K. Garner