


T.7S.R.2W.W.M.

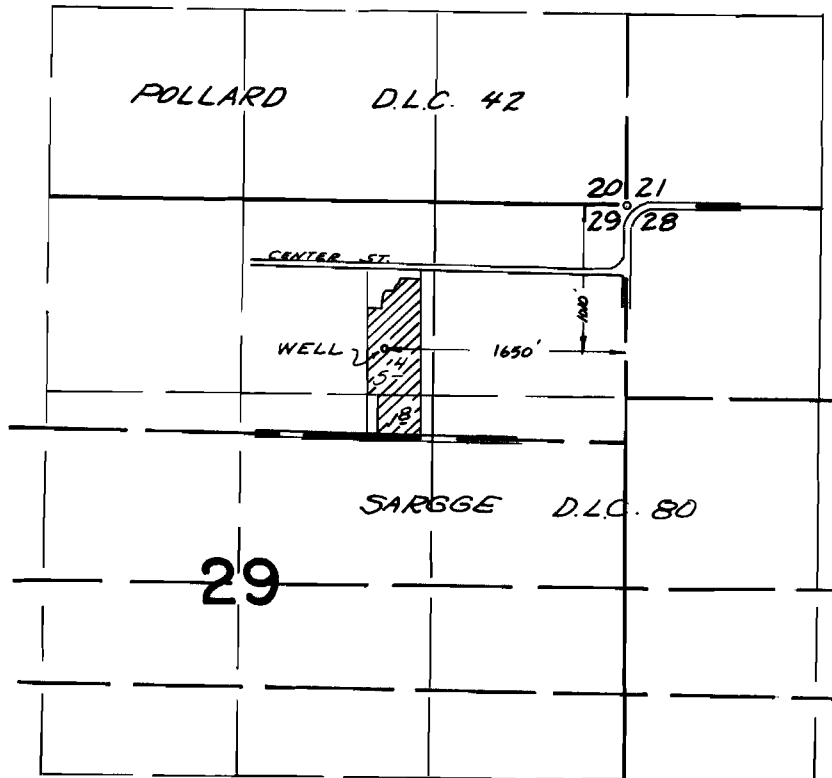

FINAL PROOF SURVEY
UNDER

Application No. G-2936 Permit No. G-2824
IN NAME OF

SALEM GOLF LAND INC.

Surveyed MAY 9, 1968, by V. GARNER