


T.6S. R.2W. W.M.

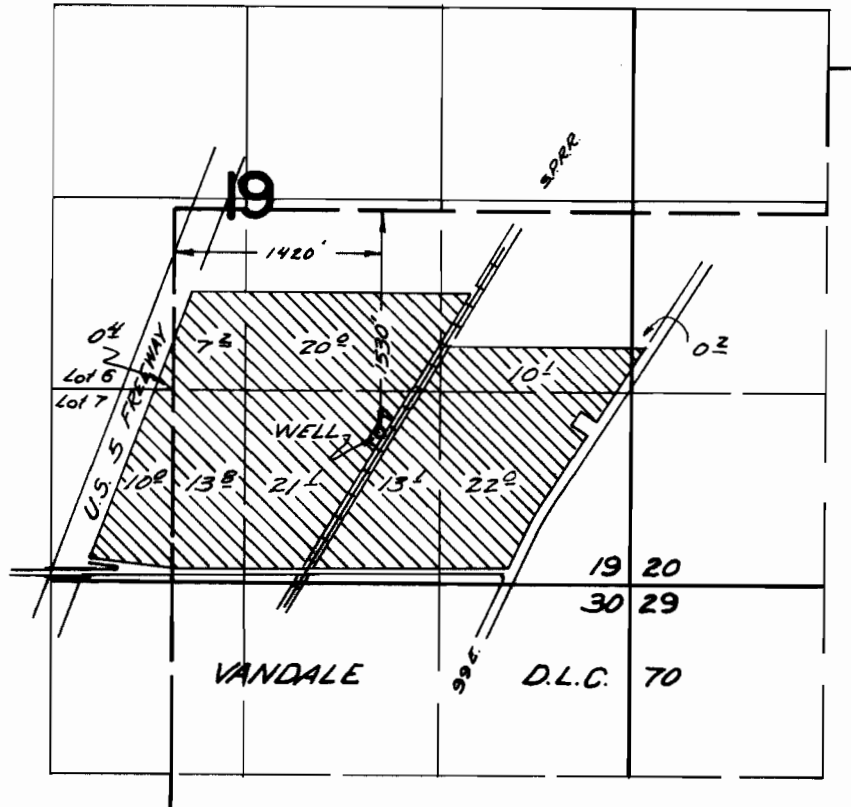

FINAL PROOF SURVEY UNDER

Application No. *G-3096*. Permit No. *G-2891*.
IN NAME OF

TERMINAL ICE and COLD STORAGE CO.

Surveyed *April 10, 1968*, by *V. Garner*.