


# T. 7S. R.3W. W.M.

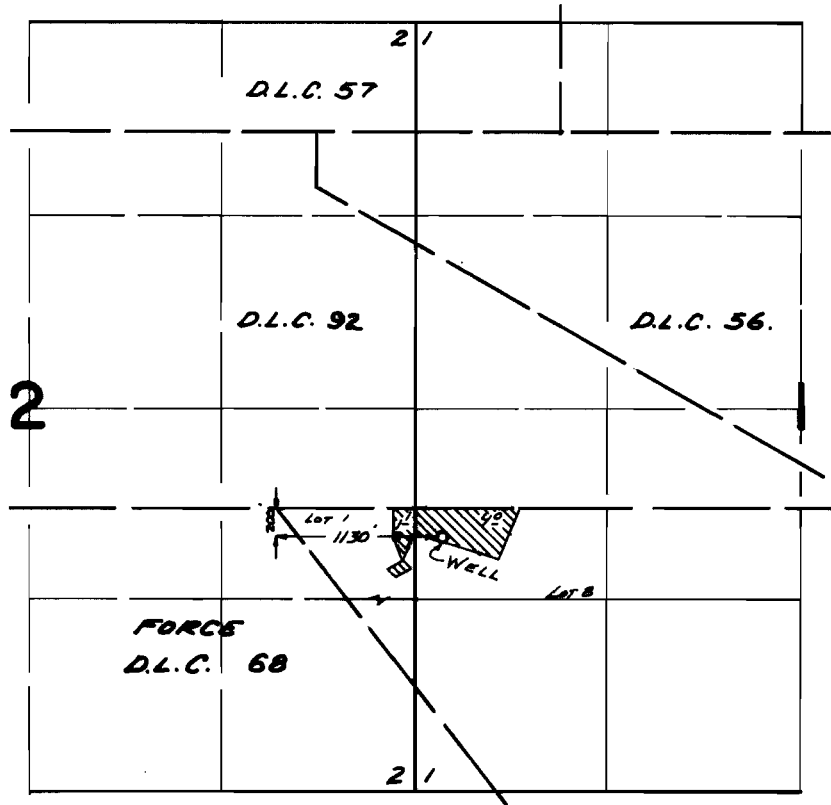

## FINAL PROOF SURVEY UNDER

Application No. *G-3108*... Permit No. *G-2903*...  
IN NAME OF

*WILLIAM MCKINLEY PANTHER*

Surveyed *June 21, 1968*, by *V. Garner*