


T.8 S. R.2 W. W.M.

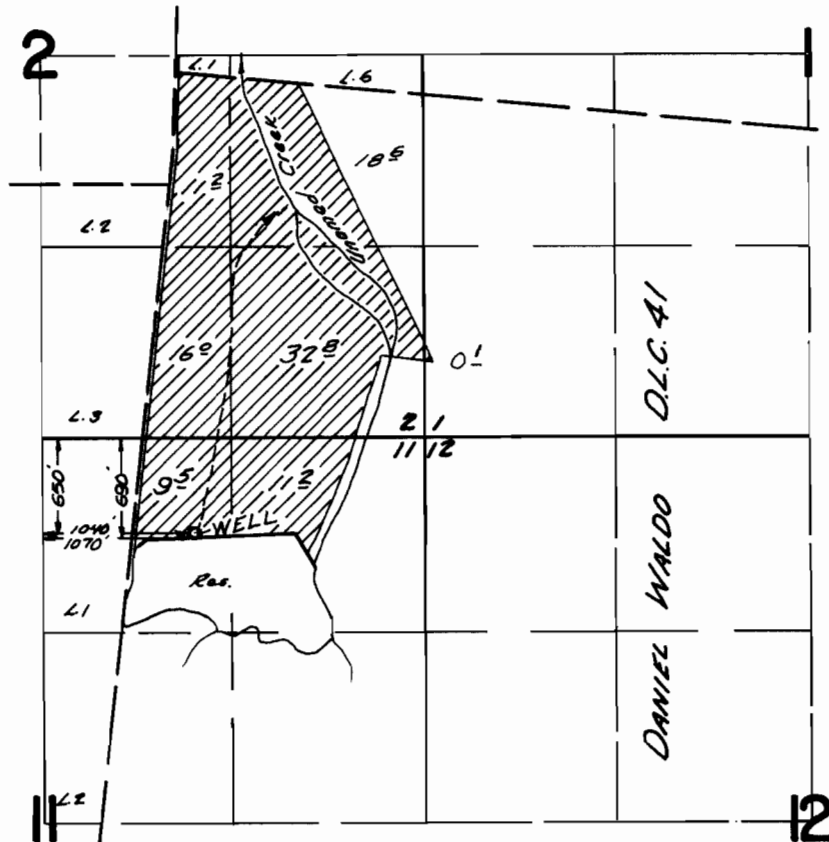

**FINAL PROOF SURVEY**  
UNDER

Application No. G-3483 Permit No. G-3236  
42183 31713  
IN NAME OF

LLOYD M. HILL INC.

Surveyed May 8 1968, by V. GARNER