T. 8 S. R. 2 W. W.M.

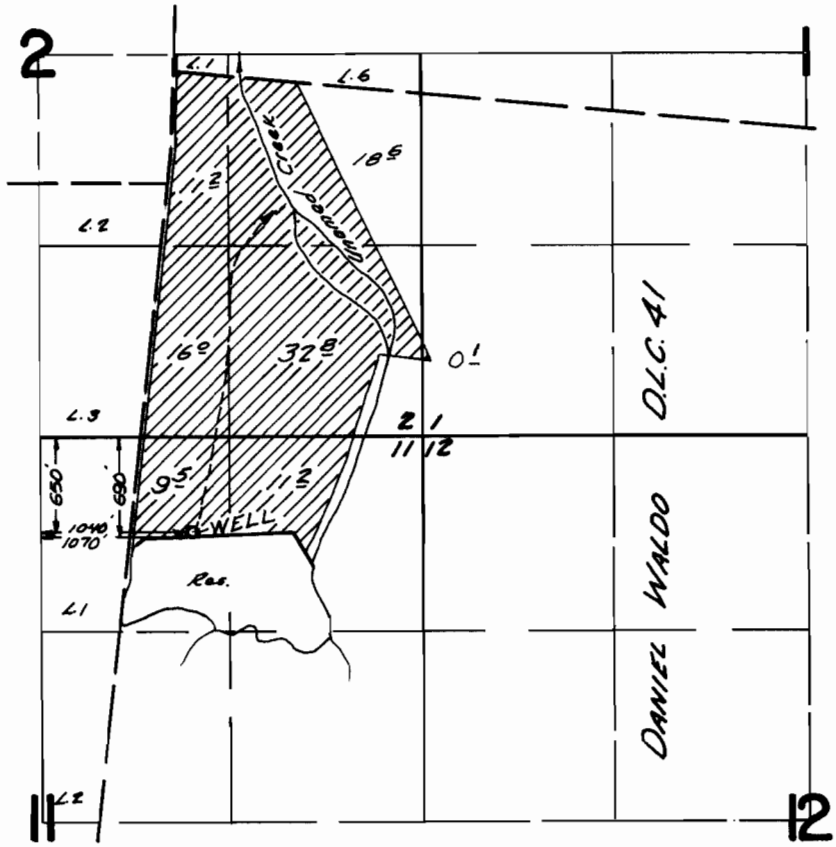

FINAL PROOF SURVEY
UNDER

Application No. 42183 (G-3483) Permit No. 31713 (G-3236)

IN NAME OF

LLOYD M. HILL INC.

Surveyed May 8 1968, by V. GARNER

INSP-1961-Z