


T.9S. R.2W. W.M.

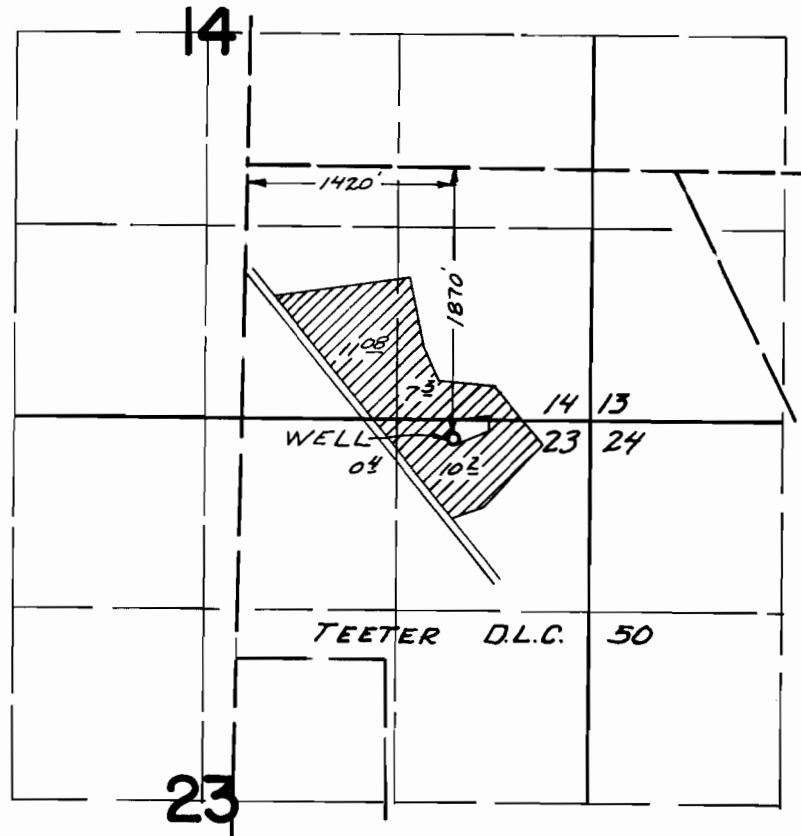

FINAL PROOF SURVEY UNDER

Application No. *G-3562*. Permit No. *G-3360*.
IN NAME OF

CARL L. HATCH

Surveyed *July 1, 1968*, by *V. Garner*