


# T.6 S. R.3 W. W.M.

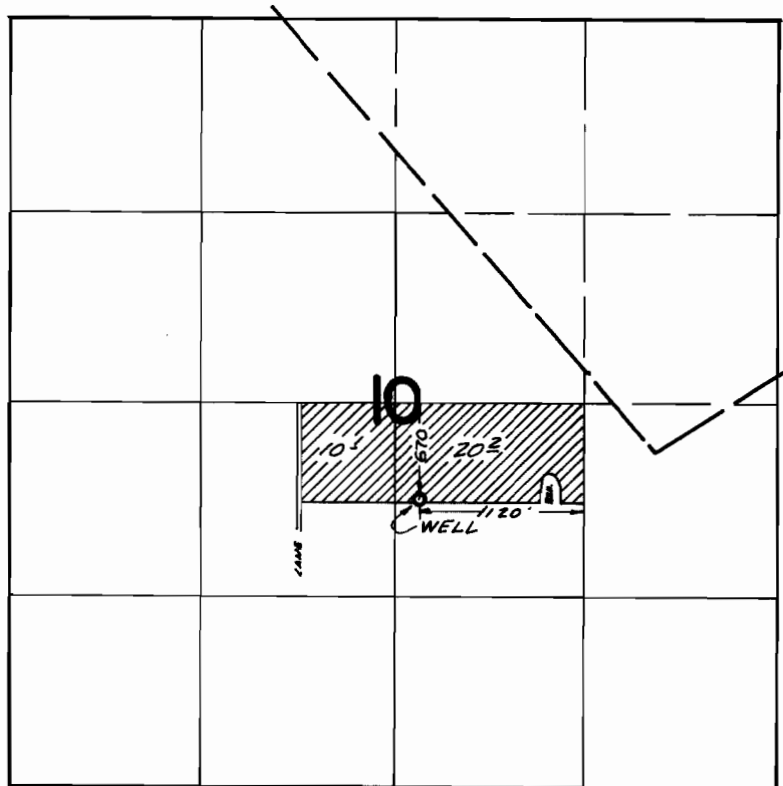

## FINAL PROOF SURVEY UNDER

Application No. ~~G:3658~~ Permit No. ~~G:3578~~  
IN NAME OF

..... GLENN M. WALTON .....

Surveyed April 23 1968 by V. Garner.....