


T.6S. R.2W. W.M.

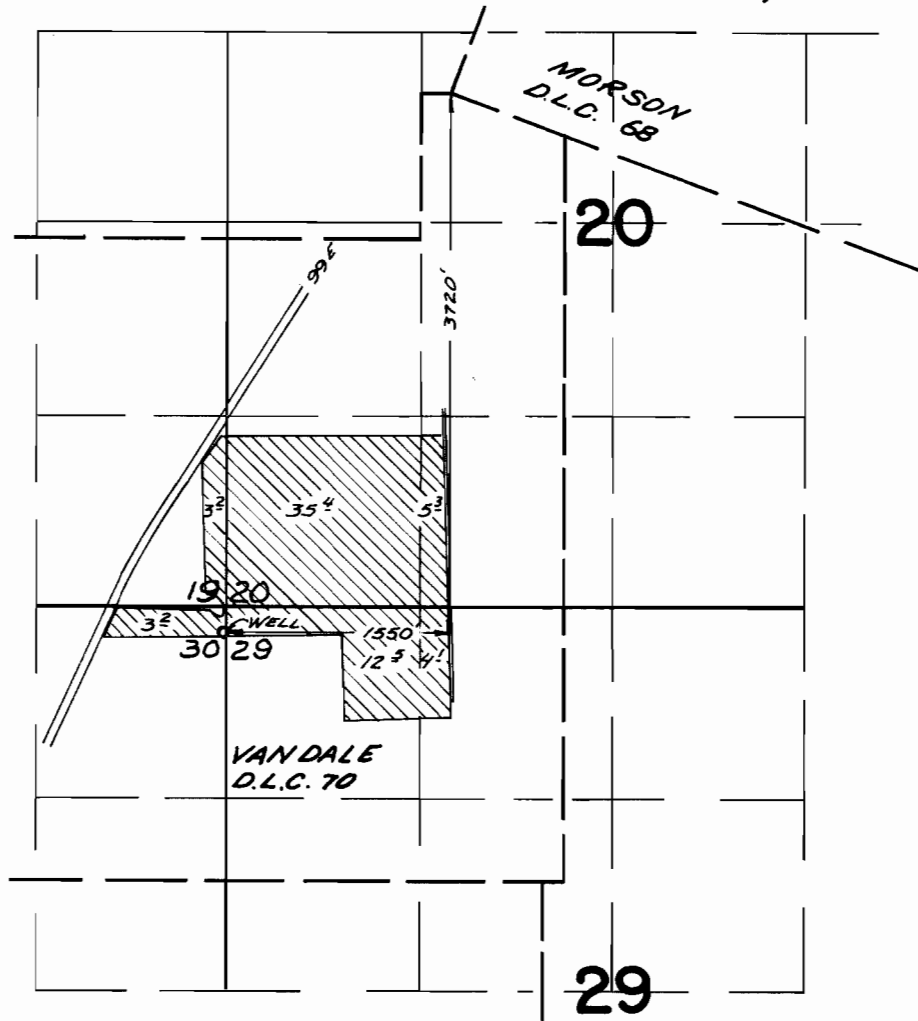

FINAL PROOF SURVEY UNDER

Application No. *G-3811* Permit No. *G-359.6*
IN NAME OF

EARL STONEBROOK

Surveyed *April 24 1968*, by *V. GARNER*