


T 6 S. R. 2 & 3 W. W.M.

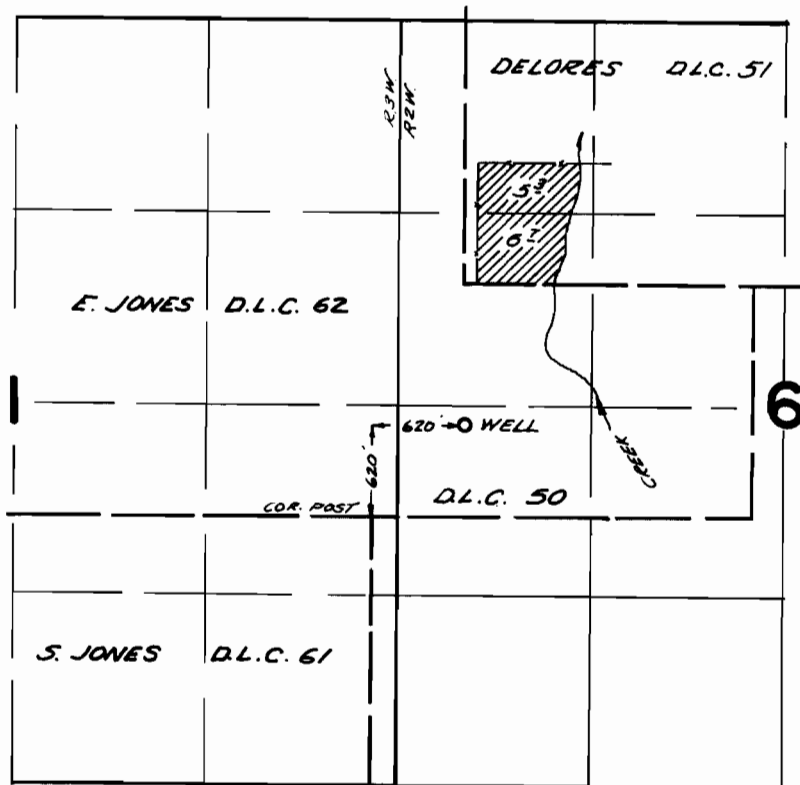

FINAL PROOF SURVEY UNDER

Application No. G-3822 Permit No. G-3603
IN NAME OF

T. V. BELL

Surveyed Aug. 15, 1968, by V. Garner