


T. 6 S. R. 2 W. W.M.

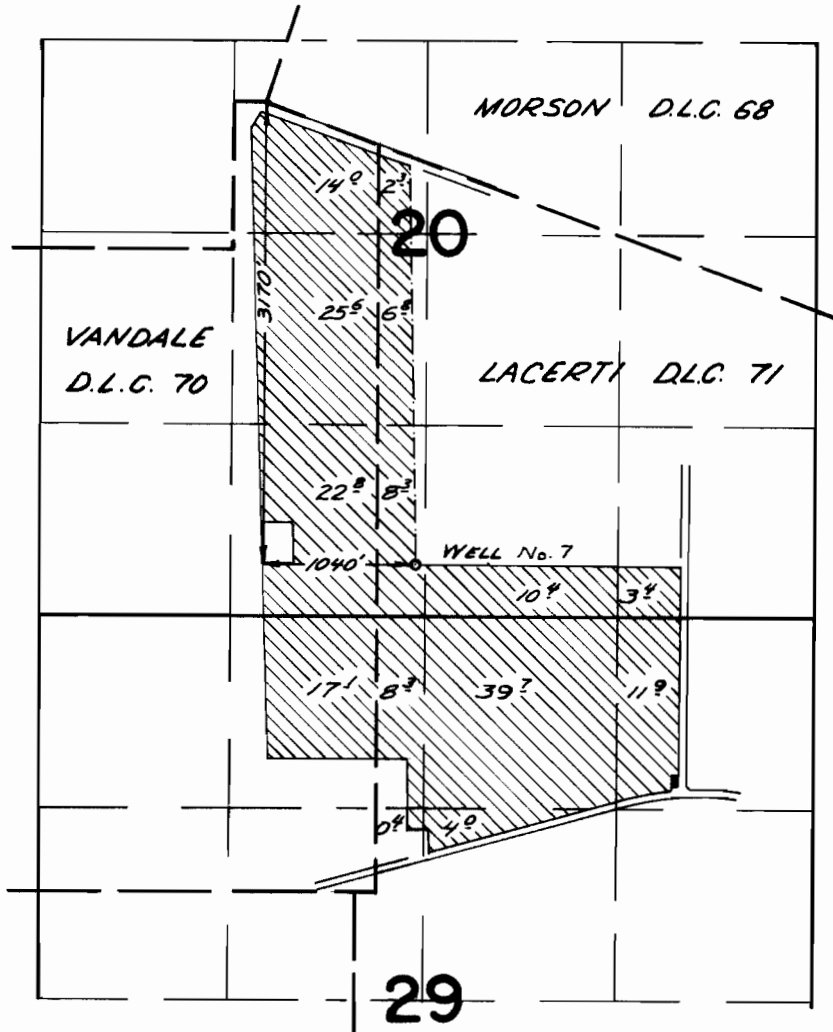

FINAL PROOF SURVEY UNDER

Application No. G-3878 Permit No. G-3646
IN NAME OF

J.W. FITTS

Surveyed April 24 1968, by *V. Garner*