T.6 S. R.2&3 W. W.M.

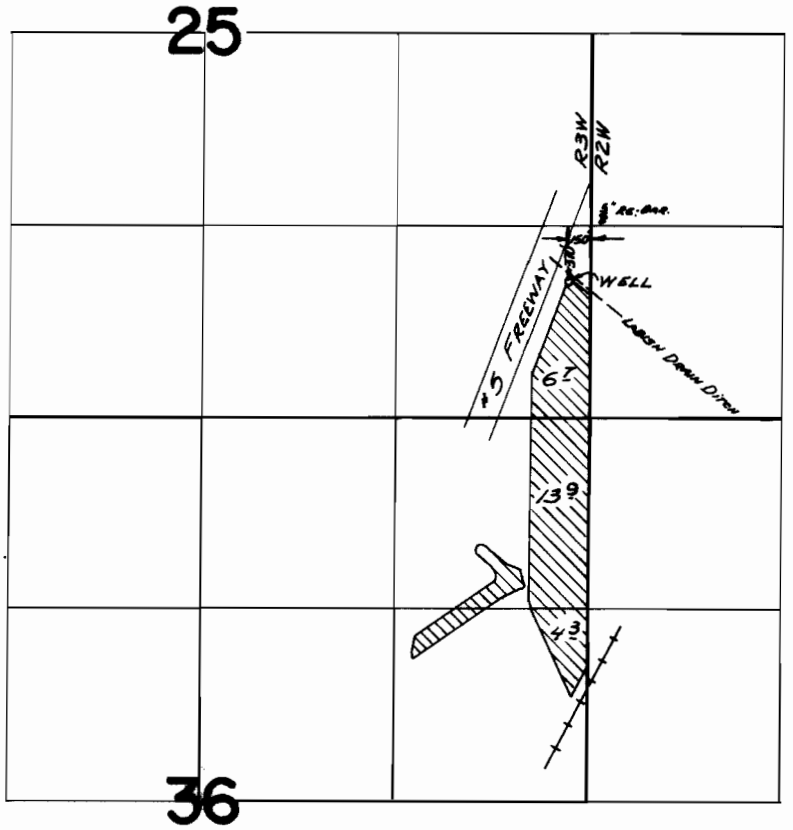

FINAL PROOF SURVEY
UNDER

Application No. G-3928 Permit No. G-3687
IN NAME OF

ARNOLD K. NICOLET

Surveyed APRIL 12 1968, by V. GARNER

1968-A